USE TYPEWRITER OR BALL POINT PEN-PRESS FIRMLY, PRINT CLEARLY.

T R EW sec 1/4 1/4 1/4 No.

WATER WELL RECORD
KSA 82a-1201-1215

Kansas State Dept. Of Health
(Water Well Contractors)
Forbes-Bldg. 740
Topeka, Kansas 66620

SE NW SW

1 Location of well:	County	Township name	Fraction	Section number	Town number	Ronge number
	Sedgwick	Deland	~~T 22 S~~	17	27S	R-1-W

Distance and direction from nearest town or city: 2 west Wichita

Street address of well location if in city: 927 N Maize Rd

3 Owner of well: Ray Stats

Address: 11529 Valley High

Locote with "X" in section below: Sketch map:

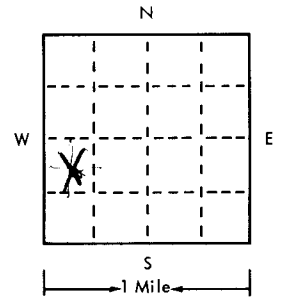

2 Type and color of material	From	To
gray Clay	0	31
sand mixed with clay	30	45
sand	45	65
(use a second sheet if needed)		

4 Well depth: 65 ft. Date of completion 4-16-75
Well diameter 5 in.

5 ☐ Cable tool ☒ Rotary ☐ Driven ☐ Dug ☐ Hollow rod ☐ Jetted ☐ Bored ☐ Reverse rotary

6 Use: ☒ Domestic ☐ Public supply ☐ Industry ☐ Irrigation ☐ Air conditioning ☐ Commercial ☐ Test well ☐ _____

7 Casing: Material PMP Steel Height: (above) below
Threaded ☐ Welded ☐ Surface 18 in.
Diam. 5 in. to 65 ft. depth Weight ~~1~~ lbs./ft.
Drive shoe? ☐ Yes ☒ No
___ in. to ___ ft. depth

8 Screen:
Manufacturer J&H owned
Type Stainless Dia. 5"
Slot/gauze 1/4 x 1/16 Length 10'
Set between 65 ft. and 55 ft.
Fittings:
Gravel pack ☒ Yes ☐ No Size range of material 3/8

9 Static water level:
35 ft. below lond surface Date 4-16-75

10 Pumping level below land surfaces:
___ ft. after ___ hrs. pumping ___ g.p.m.
___ ft. after ___ hrs. pumping ___ g.p.m.
Estimated maximum yield ___ g.p.m.

11 Woter sample submitted:
☐ Yes ☒ No Date ___

12 Well head completion:
☐ Pitless adapter ☒ 18 Inches above grade

13 Well grouted? ☒ Yes ☐ No
☐ Neat cement ☐ Bentonite ☒ cement
Depth: From 14 ft. to 3 ft.

14 Nearest spurce of possible contamination:
1/4 mile Direction west Type creek
Well disinfected upon completion? ☒ Yes ☐ No

15 Pump: ☐ Not installed
Manufacturer's name pumpco
Model number 2348 HP 1/2 Volts 220
Length of drop pipe 50 ft. capacity 15 g.m.p.
Type:
☒ Submersible ☐ Turbine
☐ Jet ☐ Reciprocating
☐ Certrifugal ☐ Other

16 Remarks: elevation

Topography:
☒ Hill
☐ Slope
☐ Upland
☐ Valley

17 Water well contractor's certification:
This well was drilled under my jurisdiction and this report is true to the best of my knowledge and belief.
Business name Wenzinger Drilling License No. 238
Address Jim Wenzinger
Signed Mary Wenz Date 5-24-75
Authorized representative

Forward the white, blue and pink copies to the Kansas State Dept. Of Health.

Form WWC-5

27 R1W 17 SENW SW

677-H