USE TYPEWRITER OR BALL POINT PEN-PRESS FIRMLY, PRINT CLEARLY.

WATER WELL RECORD
KSA 82a-1201-1215

Kansas Department of Health and Environment-Division of Environment
(Water well Contractors)
Topeka, Kansas 66620

1. Location of well:	County	Fraction	Section number	Township number	Range number
	SEdgwick	NW 1/4 NW 1/4 NW 1/4	17	T 27 S	R 1 E/W

2. Distance and direction from nearest town or city:
Street address of well location if in city: 1395 Valleyview Wichita, Kansas

3. Owner of well: John Harrison
R.R. or street: 1395 Valleyview
City, state, zip code: Wichita, Kansas 67212

4. Locate with "X" in section below: Sketch map:

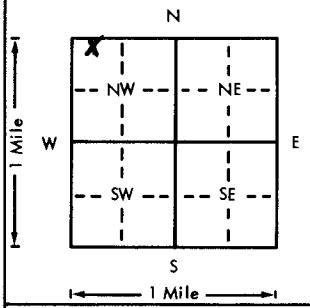

6. Bore hole dia. 11 in. Completion date
Well depth 50 ft. 12-14-76

7. __ Cable tool X Rotary __ Driven __ Dug
__ Hollow rod __ Jetted __ Bored __ Reverse rotary

8. Use: __ Domestic __ Public supply __ Industry
X Irrigation __ Air conditioning __ Stock
X Lown __ Oil field water __ Other

9. Casing: Material styrene gl Height: Above or below
Threaded __ Welded __ Surface 12 in.
RMP X PVC __ Weight __ lbs./ft.
Dia. 5 in. to 50 ft. depth Wall Thickness: inches or
Dia. __ in. to __ ft. depth gage No. .200

5. Type and color of material	From	To
Sandy Soil	0	2
Clay	2	12
Fine Sand	12	18
Medium Sand	18	43
Clay	43	50
(Use a second sheet if needed)		

10. Screen: Manufacturer's name Sunflower Plastic
Type styrene Dia. 5"
Slot/gauge .06 Length 20'
Set between 30 ft. and 50 ft.
ft. and ft.
Gravel pack? yes Size range of material 1-1/8"

11. Static water level: mo./day/yr.
20 ft. below land surface Date 12-14-76

12. Pumping level below land surfaces:
ft. after hrs. pumping g.p.m.
ft. after hrs. pumping g.p.m.
Estimated maximum yield g.p.m.

13. Water sample submitted: mo./day/yr.
__ Yes __ No Date

14. Well head completion: well seal
__ Pitless adapter 12 Inches above grade

15. Well grouted? yes
With: __ Neat cement __ Bentonite X Concrete
Depth: From 0 ft. to 10 ft.

16. Nearest source of possible contamination: City
ft. 50 Direction South Type Sewer
Well disinfected upon completion? X Yes __ No

17. Pump: __ Not installed
Manufacturer's name Sta-Rite
Model number 20P4D02 HP 3/4 Volts 230
Length of drop pipe 35 ft. capacity 20 g.p.m.
Type:
X Submersible __ Turbine
__ Jet __ Reciprocating
__ Centrifugal __ Other

18. Elevation:
Topography:
__ Hill
X Slope
__ Upland
__ Valley

19. Remarks:
Well to be used for lawn only.

20. Water well contractor's certification:
This well was drilled under my jurisdiction and this report is true to the best of my knowledge and belief.
Harp Well & Pump 236
Business name License No.
Address Wichita, Kansas
Signed M. Arnold Date 12-20-76
Authorized representative

T 27 R 1 W Sec 17 1/4 1/4 1/4

Forward the white, blue and pink copies to the Department of Health and Environment

Form WWC-5

MI-1023