

1 LOCATION OF WATER WELL: County: <u>Sedgwick</u>	Fraction <u>SE 1/4 NE 1/4 SE 1/4</u>	Section Number <u>17</u>	Township Number T <u>27</u> S	Range Number R <u>1</u> E <u>W</u>
--	---	-----------------------------	----------------------------------	---------------------------------------

Distance and direction from nearest town or city street address of well if located within city?

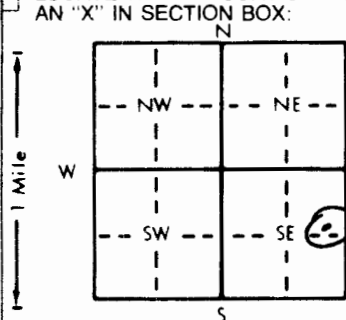
1207 N. WOOD2 WATER WELL OWNER: VERNON GLEISSNERRR#, St. Address, Box #: 1207 N. WOOD

Board of Agriculture, Division of Water Resources

City, State, ZIP Code: WICHITA, KS 67212

Application Number:

3 LOCATE WELL'S LOCATION WITH AN "X" IN SECTION BOX:

4 DEPTH OF COMPLETED WELL: 40 ft. ELEVATION:Depth(s) Groundwater Encountered 1. N/A ft. 2. N/A ft. 3. N/A ft.WELL'S STATIC WATER LEVEL 25 ft. below land surface measured on mo/day/yr 8-19-93Pump test data: Well water was N/A ft. after N/A hours pumping N/A gpmEst. Yield N/A gpm: Well water was N/A ft. after N/A hours pumping N/A gpmBore Hole Diameter 8 in. to 25 ft., and N/A in. to N/A ft.

WELL WATER TO BE USED AS: 5 Public water supply 8 Air conditioning 11 Injection well

1 Domestic 3 Feedlot 6 Oil field water supply 9 Dewatering 12 Other (Specify below)

2 Irrigation 4 Industrial 7 Lawn and garden only 10 Monitoring well

Was a chemical/bacteriological sample submitted to Department? Yes N/A No X; If yes, mo/day/yr sample was submittedWater Well Disinfected? Yes X No

5 TYPE OF BLANK CASING USED:

5 Wrought iron

8 Concrete tile

CASING JOINTS: Glued X Clamped

1 Steel

3 RMP (SR)

6 Asbestos-Cement

9 Other (specify below)

Welded

2 PVC

4 ABS

7 Fiberglass

Threaded

Blank casing diameter 5 in. to 30 ft., Dia. 30 in. to 40 ft., Dia. 40 in. to 44 ft.Casing height above land surface 12 in., weight 200 lbs./ft. Wall thickness or gauge No. 44

TYPE OF SCREEN OR PERFORATION MATERIAL:

1 Steel

3 Stainless steel

5 Fiberglass

7 PVC

10 Asbestos-cement

2 Brass

4 Galvanized steel

6 Concrete tile

8 RMP (SR)

11 Other (specify)

9 ABS

12 None used (open hole)

SCREEN OR PERFORATION OPENINGS ARE:

1 Continuous slot

3 Mill slot

5 Gauzed wrapped

8 Saw cut

11 None (open hole)

2 Louvered shutter

4 Key punched

6 Wire wrapped

9 Drilled holes

7 Torch cut

10 Other (specify)

SCREEN-PERFORATED INTERVALS: From 30 ft. to 40 ft., From 40 ft. to 44 ft.From N/A ft. to N/A ft., From N/A ft. to N/A ft.GRAVEL PACK INTERVALS: From N/A ft. to N/A ft., From N/A ft. to N/A ft.From N/A ft. to N/A ft., From N/A ft. to N/A ft.

6 GROUT MATERIAL:

1 Neat cement

2 Cement grout

3 Bentonite

4 Other

Grout Intervals: From 0 ft. to 11 ft., From 11 ft. to 30 ft., From 30 ft. to 40 ft.

What is the nearest source of possible contamination:

1 Septic tank

4 Lateral lines

7 Pit privy

10 Livestock pens

14 Abandoned water well

2 Sewer lines

5 Cess pool

8 Sewage lagoon

11 Fuel storage

15 Oil well/Gas well

3 Watertight sewer lines

6 Seepage pit

9 Feedyard

12 Fertilizer storage

16 Other (specify below)

13 Insecticide storage

Direction from well? NHow many feet? 30

FROM	TO	LITHOLOGIC LOG	FROM	TO	PLUGGING INTERVALS
09	20	TOP SOIL			
20	31	BRN SAND			
31	40	BRN & WHT SAND			
		BRN & WHT PEASIZE GRAVEL			

7 CONTRACTOR'S OR LANDOWNER'S CERTIFICATION: This water well was (1) constructed, (2) reconstructed, or (3) plugged under my jurisdiction and was completed on (mo/day/year) 8-19-93 and this record is true to the best of my knowledge and belief. KansasWater Well Contractor's License No. 313 This Water Well Record was completed on (mo/day/yr) 8-19-93 under the business name of JET DRILLING by (signature) John L. Luman