

1 LOCATION OF WATER WELL:		Fraction	Section Number		Township Number		Range Number	
County:	SEDGWICK	SE ¼ NW ¼ NW ¼	18		T 27 S		R 1 W E(W)	

Distance and direction from nearest town or city street address of well if located within city?


1113 Partridge Circle Wichita, KS.

2] WATER WELL OWNER: Cindy Niederee
RR#, St. Address, Box # : 1113 Partridge Circle
City, State, ZIP Code : Wichita, KS.

Board of Agriculture, Division of Water Resources
Application Number:

3 LOCATE WELL'S LOCATION WITH AN "X" IN SECTION BOX:

4. DEPTH OF COMPLETED WELL 50 ft. ELEVATION:
 Depth(s) Groundwater Encountered 1. 15 ft. 2. ft. 3. ft.
 WELL'S STATIC WATER LEVEL 15 ft. below land surface measured on mo/day/yr 10-7-87

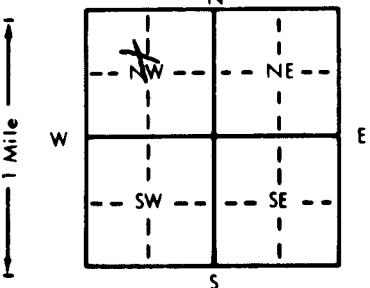

Pump test data: Well water was ft. after hours pumping gpm
 Est. Yield gpm: Well water was ft. after hours pumping gpm
 Bore Hole Diameter 11 in. to ft., and in. to ft.
 WELL WATER TO BE USED AS: 5 Public water supply 8 Air conditioning 11 Injection well
 1 Domestic 3 Feedlot 6 Oil field water supply 9 Dewatering 12 Other (Specify below)
 2 Irrigation 4 Industrial 7 Lawn and garden only 10 Observation well
 Was a chemical/bacteriological sample submitted to Department? Yes.....No...XX...; If yes, mo/day/yr sample was submitted
 Water Well Disinfected? Yes XX No

5 TYPE OF BLANK CASING USED: 5 Wrought iron 8 Concrete tile CASING JOINTS: Glued XX Clamped
 1 Steel 3 RMP (SR) 6 Asbestos-Cement 9 Other (specify below) Welded
 2 PVC 4 ABS 7 Fiberglass Cer-Mac styrene SDR-26 Threaded
 Blank casing diameter 5 in. to 30 ft. Dia. in. to ft. Dia. in. to ft.
 Casing height above land surface 12 in. weight 1.59 lbs./ft. Wall thickness or gauge No. .203

TYPE OF SCREEN OR PERFORATION MATERIAL:

1 Steel	3 Stainless steel	5 Fiberglass	7 PVC	10 Asbestos-cement
2 Brass	4 Galvanized steel	6 Concrete tile	8 RMP (SR)	11 Other (specify)
			9 ABS	12 None used (open hole)

SCREEN OR PERFORATION OPENINGS ARE: 5 Gauzed wrapped 8 Saw cut 11 None (open hole)

1 Continuous slot 3 Mill slot 6 Wire wrapped ~~9 Drilled holes~~
2 Louvered shutter 4 Key punched 7 Torch cut 10 Other (specify)

SCREEN-PERFORATED INTERVALS:	From 30 ft. to 30 ft.,	From ft. to ft.
	From 24 ft. to 50 ft.,	From ft. to ft.
GRAVEL PACK INTERVALS:	From 24 ft. to 50 ft.,	From ft. to ft.
	From ft. to ft.,	From ft. to ft.

6	GROUT MATERIAL:		1 Neat cement	2 Cement grout	3 Bentonite	4 Other
	Grout intervals:	From	4	ft. to	24	ft.
		From		ft. to		ft.
		From		ft. to		ft.

What is the nearest source of possible contamination:

1 Septic tank	4 Lateral lines	7 Pit privy	10 Livestock pens	14 Abandoned water well
2 Sewer lines	5 Cess pool	8 Sewage lagoon	11 Fuel storage	15 Oil well/Gas well
3 Watertight sewer lines	6 Seepage pit	9 Feedyard	12 Fertilizer storage	16 Other (specify below)
			13 Insecticide storage	

Direction from well?	North West	How many feet?	100
----------------------	------------	----------------	-----

[illegible]

7 CONTRACTOR'S OR LANDOWNER'S CERTIFICATION: This water well was (1) constructed, (2) reconstructed, or (3) plugged under my jurisdiction and was completed on (mo/day/year) 10-7-87 and this record is true to the best of my knowledge and belief. Kansas Water Well Contractor's License No. 236 This Water Well Record was completed on (mo/day/yr) 4-30-88 under the business name of Harp Well & Pump Service, Inc. by (signature) Mark Arnold

INSTRUCTIONS: Use typewriter or ball point pen. PLEASE PRESS FIRMLY and PRINT clearly. Please fill in blanks, underline or circle the correct answers. Send top three copies to Kansas Department of Health and Environment, Bureau of Water Protection, Topeka, Kansas 66620-7320, Telephone: 913-862-9360. Send one to WATER WELL OWNER and retain one for your records.