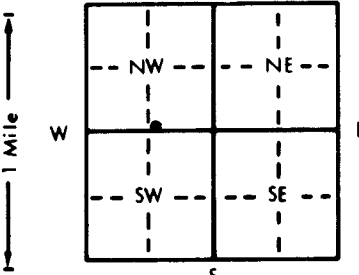


1 LOCATION OF WATER WELL:		Fraction	Section Number	Township Number	Range Number
County: <u>Sedgewick</u>		<u>SW</u> $\frac{1}{4}$ <u>SE</u> $\frac{1}{4}$ <u>NE</u> $\frac{1}{4}$	<u>18</u>	T <u>27</u> S	R <u>1</u> EW
Distance and direction from nearest town or city street address of well if located within city? <u>11502 W. Lost Creek Circle</u>					
2 WATER WELL OWNER: <u>Melvin Rolf</u> RR#, St. Address, Box #: <u>11502 W. Lost Creek Circle</u> City, State, ZIP Code: <u>Wichita, KS</u> Board of Agriculture, Division of Water Resources Application Number:					
3 LOCATE WELL'S LOCATION WITH AN "X" IN SECTION BOX:		4 DEPTH OF COMPLETED WELL: <u>100</u> ft. ELEVATION:			
		Depth(s) Groundwater Encountered 1. ft. 2. ft. 3. ft.			
		WELL'S STATIC WATER LEVEL ft. below land surface measured on mo/day/yr			
		Pump test data: Well water was ft. after hours pumping gpm			
		Est. Yield <u>27</u> gpm; Well water was ft. after hours pumping gpm			
Bore Hole Diameter: <u>12 1/4</u> in. to <u>80</u> in. to ft.		WELL WATER TO BE USED AS:			
1 Domestic		3 Feedlot	6 Oil field water supply	9 Dewatering	12 Other (Specify below)
<u>2 Irrigation</u>		4 Industrial	7 Lawn and garden only	10 Monitoring well	
Was a chemical/bacteriological sample submitted to Department? Yes.....No <u>✓</u> ; If yes, mo/day/yr sample was submitted		Water Well Disinfected? Yes <u>✓</u> No			
5 TYPE OF BLANK CASING USED:					
1 Steel		3 RMP (SR)	5 Wrought iron	8 Concrete tile	CASING JOINTS: Glued <u>✓</u> Clamped
<u>2 PVC</u>		4 ABS	6 Asbestos-Cement	9 Other (specify below)	Welded
Blank casing diameter <u>6</u> in. to <u>80</u> ft., Dia		7 Fiberglass			Threaded
Casing height above land surface <u>18</u> in., weight <u>160</u> lbs./ft. Wall thickness or gauge No. <u>SPR 24</u>					
TYPE OF SCREEN OR PERFORATION MATERIAL:					
1 Steel		3 Stainless steel	5 Fiberglass	8 RMP (SR)	10 Asbestos-cement
2 Brass		4 Galvanized steel	6 Concrete tile	9 ABS	11 Other (specify)
SCREEN OR PERFORATION OPENINGS ARE:		5 Gauzed wrapped	8 Saw cut	11 None (open hole)	
1 Continuous slot		<u>3 Mill slot</u>	6 Wire wrapped	9 Drilled holes	
2 Louvered shutter		4 Key punched	7 Torch cut	10 Other (specify)	
SCREEN-PERFORATED INTERVALS: From <u>80</u> ft. to <u>100</u> ft., From ft. to ft.					
GRAVEL PACK INTERVALS: From <u>20</u> ft. to <u>100</u> ft., From ft. to ft.					
6 GROUT MATERIAL:					
1 Neat cement		2 Cement grout	3 Bentonite	4 Other	
Grout intervals: From <u>0</u> ft. to <u>20</u> ft., From <u>55</u> ft. to <u>60</u> ft., From ft. to ft.					
What is the nearest source of possible contamination:		10 Livestock pens			
1 Septic tank		4 Lateral lines	7 Pit privy	11 Fuel storage	14 Abandoned water well
<u>2 Sewer lines</u>		5 Cess pool	8 Sewage lagoon	12 Fertilizer storage	15 Oil well/Gas well
3 Watertight sewer lines		6 Seepage pit	9 Feedyard	13 Insecticide storage	16 Other (specify below)
Direction from well? <u>East</u>		How many feet? <u>32</u>			
FROM	TO	LITHOLOGIC LOG	FROM	TO	PLUGGING INTERVALS
0	4	FILL DIRT CLAY			
4	22	CLAY			
22	36	SAND			
36	56	SANDY CLAY			
56	100	CORSE SAND			
7 CONTRACTOR'S OR LANDOWNER'S CERTIFICATION: This water well was (1) <u>constructed</u> , (2) reconstructed, or (3) plugged under my jurisdiction and was completed on (mo/day/year) <u>9-22-92</u> and this record is true to the best of my knowledge and belief. Kansas Water Well Contractor's License No. <u>464</u> This Water Well Record was completed on (mo/day/yr) <u>9-19-92</u> under the business name of <u>WATER WELL SERVICES</u> by (signature) <u>Randy [Signature]</u>					
INSTRUCTIONS: Use typewriter or ball point pen. PLEASE PRESS FIRMLY and PRINT clearly. Please fill in blanks, underline or circle the correct answers. Send top three copies to Kansas Department of Health and Environment, Bureau of Water, Topeka, Kansas 66620-0001. Telephone: 913-296-5545. Send one to WATER WELL OWNER and retain one for your records.					