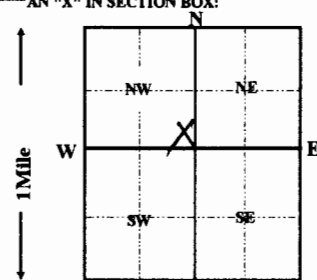


|   |  |   |  |                |  |                 |  |              |  |
|---|--|---|--|----------------|--|-----------------|--|--------------|--|
| 1 LOCATION OF WATER WELL:   |  | FRACTION   |  | Section Number |  | Township Number |  | Range Number |  |
| Sedgwick   |  | SE 1/4 SE 1/4 NW 1/4                                                                                             |  | 18             |  | T 27 S          |  | R 1W E/W     |  |
| Distance and direction from nearest town or city street address of well if located within city?   |  |   |  |                |  |                 |  |              |  |
| 11313 Lostcreek Wichita, Kansas   |  |   |  |                |  |                 |  |              |  |
| 2 WATER WELL OWNER:   |  | PIERCE, Don   |  |                |  |                 |  |              |  |
| RR#, ST. ADDRESS, BOX #:   |  | 11313 Lostcreek                                                                                                  |  |                |  |                 |  |              |  |
| CITY, STATE, ZIP CODE:   |  | Wichita, Kansas                                                                                                  |  |                |  |                 |  |              |  |
| Board of Agriculture, Division of Water Resource   |  |   |  |                |  |                 |  |              |  |
| Application Number:   |  |   |  |                |  |                 |  |              |  |
| 3 LOCATE WELL'S LOCATION WITH AN "X" IN SECTION BOX:   |  | 4 DEPTH OF COMPLETED WELL 90 ft. ELEVATION:                                                                      |  |                |  |                 |  |              |  |
|   |  | Depth(s) groundwater Encountered 1 ft. 2 ft. 3 ft.                                                               |  |                |  |                 |  |              |  |
|   |  | WELL'S STATIC WATER LEVEL 21 FT. BELOW LAND SURFACE MEASURED ON mo/day/yr 01/04/1993                             |  |                |  |                 |  |              |  |
|   |  | Pump test data: Well water was ft. after hours pumping gpm                                                       |  |                |  |                 |  |              |  |
|   |  | Est. Yield gpm: Well water was ft. after hours pumping gpm                                                       |  |                |  |                 |  |              |  |
|   |  | Bore Hole Diameter 12 in. to 90 ft., and in. to ft.                                                              |  |                |  |                 |  |              |  |
|   |  | WELL WATER TO BE USED AS: 5 Public water supply 8 Air conditioning 11 Injection well                             |  |                |  |                 |  |              |  |
|   |  | 1 Domestic 3 Feedlot 6 Oil field water supply 9 Dewatering 12 Other (Specify below)                              |  |                |  |                 |  |              |  |
|   |  | 2 Irrigation 4 Industrial 7 Lawn and garden only 10 Monitoring well                                              |  |                |  |                 |  |              |  |
|   |  | Was a chemical/bacteriological sample submitted to Department? Yes No X ; If yes, mo/day/yr sample was submitted |  |                |  |                 |  |              |  |
|   |  | Water Well Disinfected? Yes X No                                                                                 |  |                |  |                 |  |              |  |
| 5 TYPE OF CASING USED:   |  |   |  |                |  |                 |  |              |  |
| 1 Steel 3 RMP (SR) 5 Wrought iron 8 Concrete tile CASING JOINTS: Glued X Clamped   |  |   |  |                |  |                 |  |              |  |
| 2 PVC 4 ABS 6 Asbestos-Cement 9 Other (Specify below) Welded   |  |   |  |                |  |                 |  |              |  |
| 7 Fiberglass SDR-26 Threaded   |  |   |  |                |  |                 |  |              |  |
| Blank casing Diameter 5 in. to 70 ft., Dia in. to ft., Dia in. to ft.   |  |   |  |                |  |                 |  |              |  |
| Casing height above land surface 12 in., weight 2.35 lbs. / ft. Wall thickness or gauge No. .214   |  |   |  |                |  |                 |  |              |  |
| TYPE OF SCREEN OR PERFORATION MATERIAL:   |  |   |  |                |  |                 |  |              |  |
| 1 Steel 3 Stainless Steel 5 Fiberglass 8 RMP (SR) 10 Asbestos-cement   |  |   |  |                |  |                 |  |              |  |
| 2 Brass 4 Galvanized steel 6 Concrete tile 9 ABS 11 other (specify)   |  |   |  |                |  |                 |  |              |  |
| 12 None used (open hole)   |  |   |  |                |  |                 |  |              |  |
| SCREEN OR PERFORATION OPENING ARE:   |  |   |  |                |  |                 |  |              |  |
| 1 Continuous slot 3 Mill slot 5 Gauzed wrapped 8 Saw cut 11 None (open hole)   |  |   |  |                |  |                 |  |              |  |
| 2 Louvered shutter 4 Key punched 6 Wire wrapped 9 Drilled holes   |  |   |  |                |  |                 |  |              |  |
| 7 Torch cut 10 Other (specify)   |  |   |  |                |  |                 |  |              |  |
| SCREEN-PERFORATION INTERVALS: from 70 ft. to 90 ft., From ft. to ft.   |  |   |  |                |  |                 |  |              |  |
| GRAVEL PACK INTERVALS: from 24 ft. to 90 ft., From ft. to ft.   |  |   |  |                |  |                 |  |              |  |
| 6 GROUT MATERIAL: 1 Neat cement 2 Cement grout 3 Bentonite 4 Other   |  |   |  |                |  |                 |  |              |  |
| Grout Intervals: From 4 ft. to 24 ft., From ft. to ft., From ft. to ft.   |  |   |  |                |  |                 |  |              |  |
| What is the nearest source of possible contamination:   |  |   |  |                |  |                 |  |              |  |
| 1 Septic tank 4 Lateral lines 7 Pit privy 10 Livestock pens 14 Abandon water well   |  |   |  |                |  |                 |  |              |  |
| 2 Sewer lines 5 Cess pool 8 Sewage lagoon 11 Fuel storage 15 Oil well/Gas well   |  |   |  |                |  |                 |  |              |  |
| 3 Watertight sewer lines 6 Seepage pit 9 Feedyard 12 Fertilizer storage 16 Other (specify below)   |  |   |  |                |  |                 |  |              |  |
| 13 Insecticide storage   |  |   |  |                |  |                 |  |              |  |
| Direction from well? East How many feet? 80   |  |   |  |                |  |                 |  |              |  |
| FROM TO LITHOLOGIC LOG FROM TO PLUGGING INTERVALS   |  |   |  |                |  |                 |  |              |  |
| 0 3 topsoil   |  |   |  |                |  |                 |  |              |  |
| 3 21 clay   |  |   |  |                |  |                 |  |              |  |
| 21 28 fine sand   |  |   |  |                |  |                 |  |              |  |
| 28 64 clay   |  |   |  |                |  |                 |  |              |  |
| 64 72 fine sand   |  |   |  |                |  |                 |  |              |  |
| 72 90 medium sand   |  |   |  |                |  |                 |  |              |  |
| 7 CONTRACTOR'S OR LANDOWNER'S CERTIFICATION: This water well was (1) constructed, (2) reconstructed, or (3) plugged under my jurisdiction and was completed on (mo/day/year) 01/04/1993 and this record is true to the best of my knowledge and belief. Kansas Water Well Contractor's License No. 236 This Water Well Record was completed on (mo/day/yr) 03/03/93 Under the business name of Harp Well & Pump Service, Inc. by (signature) Jane Frederick |  |   |  |                |  |                 |  |              |  |