


County: SEDGWICK	Section Number: 19	Township Number: T 27 S	Range Number: R 1 W E/W
-------------------------	---------------------------	--------------------------------	--------------------------------

Distance and direction from nearest town or city street address of well if located within city?

approximately Shefford & Texas (south side of pond) Wichita, Kansas

2 WATER WELL OWNER: Falcon Homes - Falke, Jerry Constr.	Spec. House
RR#, St. Address, Box #: 14710 West 63st So.	Board of Agriculture, Division of Water Resources
City, State, ZIP Code: Clearwater, Ks.	Application Number:

3 LOCATE WELL'S LOCATION WITH AN "X" IN SECTION BOX:	4 DEPTH OF COMPLETED WELL: 60 ft. ELEVATION:
--	---

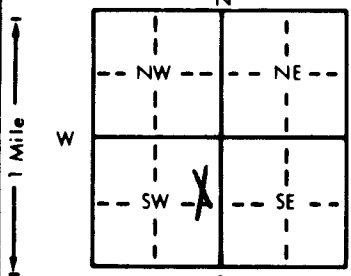

Depth(s) Groundwater Encountered **128** ft. 2. ft. 3. ft.

WELL'S STATIC WATER LEVEL **28** ft. below land surface measured on mo/day/yr **7-26-84**

Pump test data: Well water was ft. after hours pumping gpm

Est. Yield gpm: Well water was ft. after hours pumping gpm

Bore Hole Diameter **11** in. to ft., and in. to ft.

WELL WATER TO BE USED AS:

5 Public water supply	8 Air conditioning	11 Injection well
1 Domestic	3 Feedlot	6 Oil field water supply
2 Irrigation	4 Industrial	7 Lawn and garden only
		10 Observation well

Was a chemical/bacteriological sample submitted to Department? Yes No **X**; If yes, mo/day/yr sample was submitted

Water Well Disinfected? Yes **Z** No

5 TYPE OF BLANK CASING USED:	5 Wrought iron	8 Concrete tile	CASING JOINTS: Glued X Clamped
1 Steel	3 RMP (SR)	6 Asbestos-Cement	9 Other (specify below)
2 PVC	4 ABS	7 Fiberglass	Welded
Blank casing diameter 5 in. to 40 ft., Dia			Cer-Mac styrene SDR-26 Threaded
Casing height above land surface 12 in., weight 1.59 lbs./ft. Wall thickness or gauge No. 203			
TYPE OF SCREEN OR PERFORATION MATERIAL:	7 PVC	10 Asbestos-cement	
1 Steel	3 Stainless steel	5 Fiberglass	8 RMP (SR)
2 Brass	4 Galvanized steel	6 Concrete tile	9 ABS
SCREEN OR PERFORATION OPENINGS ARE:	5 Gauzed wrapped	8 Saw cut	11 None (open hole)
1 Continuous slot	3 Mill slot	6 Wire wrapped	9 Drilled holes
2 Louvered shutter	4 Key punched	7 Torch cut	10 Other (specify)
SCREEN-PERFORATED INTERVALS:	From 40 ft. to 60 ft., From		
	From		
GRAVEL PACK INTERVALS:	From 16 ft. to 60 ft., From		
	From		

6 GROUT MATERIAL:	1 Neat cement	2 Cement grout	3 Bentonite	4 Other
GROUT INTERVALS:	From 6 ft. to 16 ft., From			
What is the nearest source of possible contamination:				
1 Septic tank	4 Lateral lines	7 Pit privy	10 Livestock pens	14 Abandoned water well
2 Sewer lines	5 Cess pool	8 Sewage lagoon	11 Fuel storage	15 Oil well/Gas well
3 Watertight sewer lines	6 Seepage pit	9 Feedyard	12 Fertilizer storage	16 Other (specify below)
			13 Insecticide storage	None Apparent

Direction from well? Well to be in the basement	How many feet?
--	----------------

FROM	TO	LITHOLOGIC LOG	FROM	TO	LITHOLOGIC LOG
0	3	Topsoil			
3	22	Clay			
22	32	Fi ne Sand			
32	60	Medium Sand			

7 CONTRACTOR'S OR LANDOWNER'S CERTIFICATION: This water well was (1) constructed, (2) reconstructed, or (3) plugged under my jurisdiction and was completed on (mo/day/year) 7-26-84 and this record is true to the best of my knowledge and belief. Kansas Water Well Contractor's License No. 236 This Water Well Record was completed on (mo/day/yr) 12-20-84 under the business name of Harp Well & Pump Service, Inc by (signature) <i>Mary Arnold</i>
INSTRUCTIONS: Use typewriter or ball point pen, PLEASE PRESS FIRMLY and PRINT clearly. Please fill in blanks, underline or circle the correct answers. Send top three copies to Kansas Department of Health and Environment, Division of Environment, Environmental Geology Section, Topeka, KS 66620. Send one to WATER WELL OWNER and retain one for your records.

OFFICE USE ONLY

T

27

R

EW

SEC.

19

SE 1/4

NE 1/4

SW 1/4