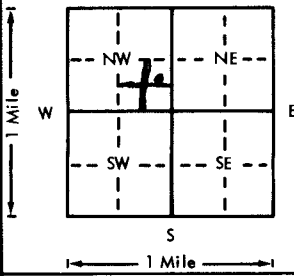
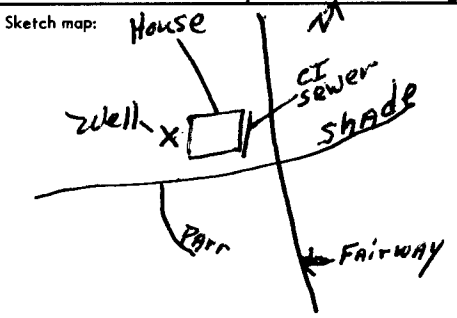


USE TYPEWRITER OR BALL
POINT PEN-PRESS FIRMLY,
PRINT CLEARLY.

WATER WELL RECORD
KSA 82a-1201-1215

Kansas Department of Health and
Environment-Division of Environment
(Water well Contractors)
Topeka, Kansas 66620

1. Location of well:		County: <u>Sedgwick</u>	Section: <u>NE SE</u> <u>NE 1/4 SW 1/4 NW 1/4</u>	Section number: <u>20</u>	Township number: <u>T 27 S</u>	Range number: <u>R 1 E</u>
2. Distance and direction from nearest town or city: Street address of well location if in city: <u>9710 SHADE</u>				3. Owner of well: <u>Earl D. Fowler</u> R.R. or street: <u>9710 SHADE</u> City, state, zip code: <u>WICHITA KS 67212</u>		
4. Locote with "X" in section below: 		Sketch map: 		6. Bore hole dia. <u>9</u> in. Completion date <u>7-21-76</u> Well depth <u>45</u> ft.		
5. Type and color of material				7. Cable tool ☐ Rotary ☐ Driven ☐ Dug ☐ ☐ Hollow rod ☐ Jetted ☒ Bored ☐ Reverse rotary		
				8. Use: Domestic ☐ Public supply ☐ Industry ☐ ☒ Irrigation ☐ Air conditioning ☐ Stock ☐ ☒ Lawn ☐ Oil field water ☐ Other		
From To <u>Dark Brown Sandy-Clay loam</u> 0 40 <u>Light " Sand Fine</u> 40 22 <u>Light " "</u> 22 35 <u>Brown Med Gravel & sand</u> 35 45 <u>45' total</u> <u>22' to water</u> <u>23' of water</u>				9. Casing: Material <u>PVC</u> Height <u>12</u> in. Threaded ☐ Welded ☒ Surface <u>12</u> in. RMP ☐ PVC ☒ Weight <u>10</u> lbs./ft. Dia. <u>6</u> in. to <u>9</u> ft. depth Wall Thickness: inches or Dia. <u>6</u> in. to <u>45</u> ft. depth gage No. <u>1032</u>		
				10. Screen: Manufacturer's name <u>Smith</u> Type <u>PVC</u> Dia. <u>10"</u> Slot/auze <u>3/16</u> Length <u>10 ft</u> Set between <u>35</u> ft. and <u>45</u> ft. Gravel pack? <u>No</u> Size range of material		
12. Pumping level below land surfaces: <u>30</u> ft. after <u>1</u> hrs. pumping <u>19</u> g.p.m. <u> </u> ft. after <u> </u> hrs. pumping <u> </u> g.p.m. Estimated maximum yield <u>2.5</u> g.p.m.				11. Static water level: <u>22</u> ft. below land surface Date <u>7-21-76</u>		
				13. Water sample submitted: <u>Yes</u> ☒ <u>No</u> ☐ Date		
14. Well head completion: <u> </u> Pitless adapter <u>12</u> inches above grade				15. Well grouted? <u>Yes</u> With: <u>Neat cement</u> ☐ <u>Bentonite</u> ☐ <u>Concrete</u> ☒ Depth: From <u>0</u> ft. to <u>10</u> ft.		
				16. Nearest source of possible contamination: ft. <u>100</u> Direction <u>West</u> Type <u>sewer</u> Well disinfected upon completion? <u>Yes</u> ☒ <u>No</u> ☐		
17. Pump: Manufacturer's name <u>FBW</u> Not installed Model number <u>5BK5</u> HP <u>1/2</u> Volts <u>115</u> Length of drop pipe <u>40</u> ft. capacity <u>19</u> g.p.m. Type: ☒ Submersible ☐ Turbine ☐ Jet ☐ Reciprocating ☐ Centrifugal ☐ Other				18. Water well contractor's certification: This well was drilled under my jurisdiction and this report is true to the best of my knowledge and belief. <u>Protheroe Pump & Well 295</u> Business name <u>827 W 27 S, Wichita KS</u> Address <u>Protheroe</u> Date <u>7-21-76</u> Signed <u>Protheroe</u> Authorized representative		
				19. Remarks: <u>LAWN & Garden</u>		
18. Elevation: Topography: ☒ Hill ☐ Slope ☐ Upland ☐ Valley						

Forward the white, blue and pink copies to the Department of Health and Environment

Form WWC-5