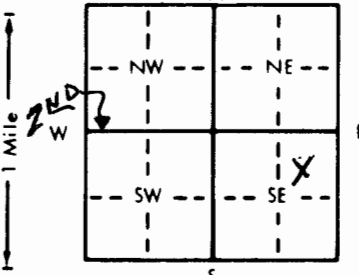


1 LOCATION OF WATER WELL:		Fraction	Section Number	Township Number	Range Number
County: Sedgwick		SE 1/4 of NE 1/4 SE 1/4	20	T 27 S	R 1 WEST E/W
Distance and direction from nearest town or city street address of well if located within city? City of Wichita-So 128.5 ft West 185ft Westfield Acres Addition (See attached map)					
2 WATER WELL OWNER: H.K.Tatum RR#, St. Address, Box # : 156 North Byron Road City, State, ZIP Code : Wichita KS 67212 Board of Agriculture, Division of Water Resources Application Number:					
3 LOCATE WELL'S LOCATION WITH AN "X" IN SECTION BOX:		4 DEPTH OF COMPLETED WELL: 53 ft. 9 in. ft. ELEVATION: Unknown			
		Depth(s) Groundwater Encountered 1. 25 ft. 6 in. ft. 2. ft. 3. ft. WELL'S STATIC WATER LEVEL 25ft. 6 in. ft. below land surface measured on mo/day/yr 10- 25-1991 Pump test data: Well water was No Test ft. after hours pumping gpm Est. Yield gpm: Well water was Run ft. after hours pumping gpm Bore Hole Diameter in. to ft. and in. to ft. WELL WATER TO BE USED AS: 5 Public water supply 8 Air conditioning 11 Injection well 1 Domestic 3 Feedlot 6 Oil field water supply 9 Dewatering 12 Other (Specify below) 2 Irrigation 4 Industrial 7 Lawn and garden only 10 Monitoring well Was a chemical/bacteriological sample submitted to Department? Yes No; If yes, mo/day/yr sample was submitted Water Well Disinfected? Yes XX No			
5 TYPE OF BLANK CASING USED: 1 Steel 6" Galv 3 RMP (SR) 2 PVC 4 ABS Blank casing diameter All 6 in. to ft. Dia. in. to ft. Dia. in. to ft. Casing height above land surface 2 in. weight Unknown lbs./ft. Wall thickness or gauge No. Unknown TYPE OF SCREEN OR PERFORATION MATERIAL: 1 Steel 3 Stainless steel 5 Fiberglass 8 RMP (SR) 10 Asbestos-cement 2 Brass 4 Galvanized steel 6 Concrete tile 9 ABS 12 None used (open hole) SCREEN OR PERFORATION OPENINGS ARE: 1 Continuous slot 3 Mill slot 5 Gauzed wrapped 8 Saw cut 11 None (open hole) 2 Louvered shutter 4 Key punched 7 Torch cut 9 Drilled holes 10 Other (specify) SCREEN-PERFORATED INTERVALS: From 43' 9" ft. to 53' 9" ft. From ft. to ft. GRAVEL PACK INTERVALS: From NONE ft. to ft. From ft. to ft. From ft. to ft. From ft. to ft.					
6 GROUT MATERIAL: 1 Neat cement 2 Cement grout XX 3 Bentonite 4 Other Grout intervals: From Surface ft. to 25ft. ft. From ft. to ft. From ft. to ft. What is the nearest source of possible contamination: 1 Septic tank 4 Lateral lines 7 Pit privy 10 Livestock pens 14 Abandoned water well 2 Sewer lines 5 Cess pool 8 Sewage lagoon 11 Fuel storage 15 Oil well/Gas well 3 Watertight sewer lines 6 Seepage pit 9 Feedyard 12 Fertilizer storage 16 Other (specify below) 13 Insecticide storage Direction from well? How many feet? FROM TO LITHOLOGIC LOG FROM TO PLUGGING INTERVALS This 6 inch cased well was drilled prior to purchase of this lot in 1952. A new well was installed nearby-see report of drilling contractor dated 8-5-91 by J Weninger. The old well was plugged 10-25-91 in accordance with field demonstration instructions and in accordance with bulletin "Plugging Abandoned Wells" MF-935 Rev Feb 1990. Work done by H.K.Tatum-Owner. Little or no data on the plugged well is available, and the information given is believed to be as accurate as possible. The well was pumped with a Berkley one half HP Vertical shaft Jet pump, until 1990 when the pump failed and was replaced with a one third HP Berkley pump. 54 25 SAND CEMENT 25 0					
7 CONTRACTOR'S OR LANDOWNER'S CERTIFICATION: This water well was (1) constructed, (2) reconstructed, or (3) plugged under my jurisdiction and was completed on (mo/day/year) 10-25-91 and this record is true to the best of my knowledge and belief. Kansas Water Well Contractor's License No. Done by owner This Water Well Record was completed on (mo/day/yr) 10-26-1991 under the business name of H.K.Tatum by (signature) H.K.Tatum					
INSTRUCTIONS: Use typewriter or ball point pen. PLEASE PRESS FIRMLY and PRINT clearly. Please fill in blanks, underline or circle the correct answers. Send top three copies to Kansas Department of Health and Environment, Bureau of Water, Topeka, Kansas 66620-7320. Telephone: 913-296-5545. Send one to WATER WELL OWNER and retain one for your records.					