USE TYPEWRITER OR BALL POINT PEN-PRESS FIRMLY, PRINT CLEARLY.

T R EW sec 1/4 1/4 1/4 No.

WATER WELL RECORD
KSA 82a-1201-1215

Kansas State Dept. Of Health
(Water Well Contractors)
Forbes-Bldg. 740
Topeka, Kansas 66620

NW SW NW NW

1 Location of well:	County: Sedg.	Township name: DELANO	Fraction: NW 1/4	Section number: 20	Town number: 27S	Range number: 1W.

Distance and direction from nearest town or city:

Street address of well location if in city: 10311 BINTER LN.

3 Owner of well: H. R. CARPENTER.

Address: 10311 Binter LN. Wichita.

Locate with "X" in section below:

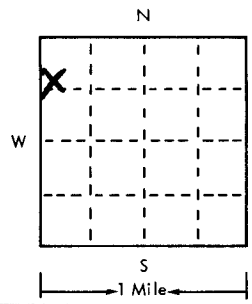

Sketch map: 10 ft. WELL HOUSE

4 Well depth: 35 ft. Date of completion 6/8
Well diameter 5 in.

5 ☐ Cable tool ☑ Rotary ☐ Driven ☐ Dug
☐ Hollow rod ☐ Jetted ☐ Bored ☐ Reverse rotary

6 Use: ☐ ~~Domestic~~ ☐ Public supply ☐ Industry
☑ Irrigation ☐ Air conditioning ☐ Commercial
☐ Test well ☐ _____

7 Casing: Material PLASTIC Height: above/below
Threaded ☐ Welded ☐ Surface 18 in.
Diam. 5 in. to 35 ft. depth Weight 160 lbs./ft. 100
Drive shoe? ☐ Yes ☑ No
___ in. to ___ ft. depth

2 Type and color of material	From	To
Top Soil	0	6
Clay	6	16
GRAVEL	16	35
Well used for Lawn IRRIGATION only		
4x4 Slab poured by driller.		
(use a second sheet if needed)		

8 Screen: Manufacturer JESSE HOWELL
Type PLASTIC Dia. 5 in.
Slot/gauze _____ Length 10 ft.
Set between 25 ft. and 35 ft.
Fittings:
Gravel pack ☑ Yes ☐ No Size range of material ___

9 Static water level:
12 ft. below land surface Date 6/8

10 Pumping level below land surface:
___ ft. after ___ hrs. pumping UNKNOWN g.p.m.
___ ft. after ___ hrs. pumping ___ g.p.m.
Estimated maximum yield 100 g.p.m.

11 Water sample submitted:
☐ Yes ☑ No Date _____

12 Well head completion:
☐ Pitless adapter 18 inches above grade

13 Well grouted? ☑ Yes ☐ No
☑ Neat cement ☐ Bentonite ☐ _____
Depth: From 0 ft. to 10 ft.

14 Nearest source of possible contamination:
ft. NONE Direction _____ Type _____
Well disinfected upon completion? ☑ Yes ☐ No

15 Pump: ☐ Not installed
Manufacturer's name VALLEY
Model number 1RPH HP 1½ Volts 230
Length of drop pipe 28 ft. Capacity 18 g.m.p.
Type:
☑ Submersible ☐ Turbine
☐ Jet ☐ Reciprocating
☐ Certrifugal ☐ Other

16 Remarks: elevation

Topography:
☐ ~~Hill~~
☑ Slope
☐ Upland
☐ Valley

17 Water well contractor's certification:
This well was drilled under my jurisdiction and this report is true to the best of my knowledge and belief.
WENINGER DRILLING 238A
Business name MAIZE KS License No.
Address _____
Signed _____ Date 6/8/
Authorized representative

Forward the white, blue and pink copies to the Kansas State Dept. Of Health.

Form WWC-5

677-H