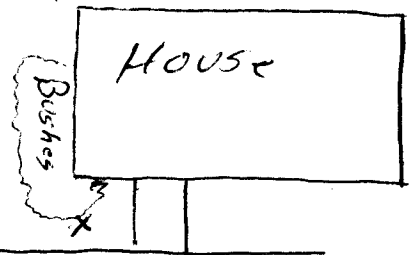


USE TYPEWRITER OR BALL
POINT PEN-PRESS FIRMLY,
PRINT CLEARLY.

WATER WELL RECORD
KSA 82a-1201-1215

Kansas Department of Health and
Environment-Division of Environment
(Water well Contractors)
Topeka, Kansas 66620

1. Location of well:		County <u>Sedgewick</u>	Fraction <u>NE 1/4 SE 1/4 NW 1/4</u>	Section number <u>20</u>	Township number <u>T 27</u>	Range number <u>S 1 N E/W</u>	
2. Distance and direction from nearest town or city: Street address of well location if in city: <u>338 FAIRWAY</u>				3. Owner of well: <u>Bob Meyers</u> R.R. or street: <u>338 FAIRWAY</u> City, state, zip code: <u>Wichita K</u>			
4. Locate with "X" in section below: N W E S 1 Mile		Sketch map: 		6. Bore hole dia. <u>11</u> in. Completion date <u>11-15-77</u> Well depth <u>106</u> ft.			
5. Type and color of material		From		To		7. ☐ Cable tool ☒ Rotary ☐ Driven ☐ Dug ☐ Hollow rod ☐ Jetted ☐ Bored ☐ Reverse rotary	
						8. Use: ☐ Domestic ☐ Public supply ☐ Industry ☒ Irrigation ☐ Air conditioning ☐ Stock ☒ Lawn ☐ Oil field water ☐ Other	
						9. Casing: Material <u>Steel</u> Height: Above or below Threaded ☐ Welded ☐ Surface <u>12</u> in. RMP ☐ PVC ☒ Weight <u>7.8</u> lbs./ft. Dia. <u>5</u> in. to <u>106</u> ft. depth Wall Thickness: inches or Dia. <u>5</u> in. to <u>106</u> ft. depth Gauge No. <u>150</u>	
						10. Screen: Manufacturer's name <u>JVL</u> Type <u>100</u> Dia. <u>5"</u> Slot/gauze <u>.065</u> Length <u>20'</u> Set between <u>80</u> ft. and <u>106</u> ft. ft. and <u>106</u> ft. Gravel pack? <u>yes</u> Size range of material <u>3/16 P 60/41</u>	
						11. Static water level: <u>20</u> ft. below land surface Date <u>11-24-77</u> 12. Pumping level below land surfaces: <u>25</u> ft. after <u>1</u> hrs. pumping <u>15</u> g.p.m. <u> </u> ft. after <u> </u> hrs. pumping <u> </u> g.p.m. Estimated maximum yield <u>50</u> g.p.m. 13. Water sample submitted: <u> </u> mo./day/yr. <u> </u> Yes ☒ No Date <u> </u>	
(Use a second sheet if needed)						14. Well head completion: ☐ Pitless adapter <u>12</u> inches above grade ☒ Well grouted? <u>yes</u> With: ☐ Neat cement ☒ Bentonite ☐ Concrete Depth: From <u>0</u> ft. to <u>10</u> ft.	
						16. Nearest source of possible contamination: ft. <u>90</u> Direction <u>E</u> Type <u>sewer</u> Well disinfected upon completion? ☒ Yes ☐ No	
						17. Pump: Manufacturer's name <u> </u> ☒ Not installed Model number <u> </u> HP <u> </u> Volts <u> </u> Length of drop pipe <u> </u> ft. capacity <u> </u> g.p.m. Type: ☐ Submersible ☐ Turbine ☐ Jet ☐ Reciprocating ☐ Centrifugal ☐ Other	
						20. Water well contractor's certification: This well was drilled under my jurisdiction and this report is true to the best of my knowledge and belief. <u>2157 Electric</u> <u>129</u> Business name License No. Address <u>512 W. 2157</u> Signed <u>J. Henry</u> Date <u> </u> Authorized representative	
						18. Elevation: Topography: ☐ Hill ☐ Slope ☐ Upland ☒ Valley	

Forward the white, blue and pink copies to the Department of Health and Environment

Form WWC-5