USE TYPEWRITER OR BALL POINT PEN-PRESS FIRMLY, PRINT CLEARLY.

WATER WELL RECORD
KSA 82a-1201-1215

SE SE SW NW 17

Kansas Department of Health and Environment-Division of Environment
(Water well Contractors)
Topeka, Kansas 66620

1. Location of well:	County: Sedgwick	Fraction: NE 1/4 SW 1/4 NE 1/4	Section number: 20	Township number: T 27 S	Range number: R 1 E (W)

2. Distance and direction from nearest town or city:
Street address of well location if in city: 10017 Harvest Lane Wichita Ks

3. Owner of well: H.N. Edger
R.R. or street: 10017 Harvest Lane
City, state, zip code: Wichita KS

4. Locate with "X" in section below:

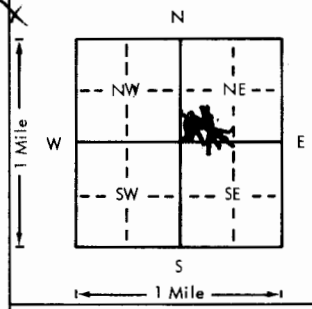

Sketch map:

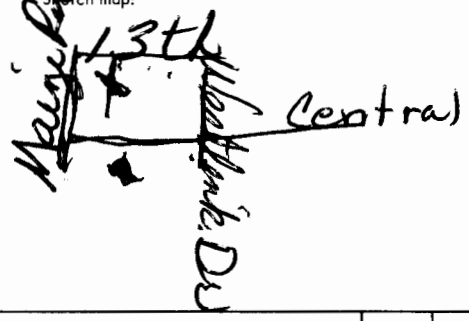

6. Bore hole dia. 8 in. Completion date 6/16
Well depth 50 ft.

7. __ Cable tool ✓ Rotary __ Driven __ Dug
__ Hollow rod __ Jetted __ Bored __ Reverse rotary

8. Use: ✓ Domestic __ Public supply __ Industry
✓ Irrigation __ Air conditioning __ Stock
__ Lawn __ Oil field water __ Other

9. Casing: Steel Height: Above or below
Threaded ___ Welded ___ Surface 2 in.
RMP ___ PVC ✓ Weight 100 lbs./ft.
Dia. 5 in. to 50 ft. depth Wall Thickness: inches or gage No. 1/4
Dia. ___ in. to ___ ft. depth

5. Type and color of material	From	To
Yellow Clay	0	30
White Sand	30	40
Brown Sand	40	50