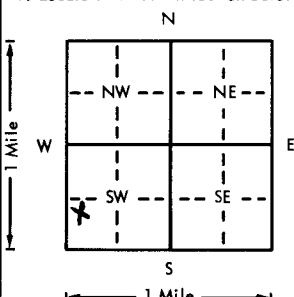
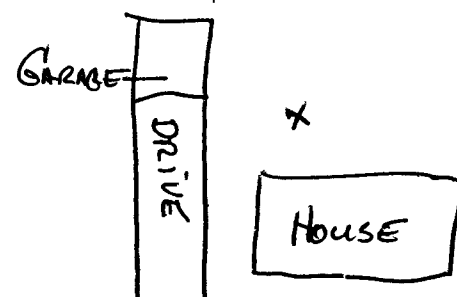


USE TYPEWRITER OR BALL
POINT PEN-PRESS FIRMLY,
PRINT CLEARLY.

WATER WELL RECORD
KSA 82a-1201-1215

Kansas Department of Health and
Environment-Division of Environment
(Water well Contractors)
Topeka, Kansas 66620

1. Location of well:		County SEDOGWICK	Fraction NW 1/4 SW 1/4 SW 1/4	Section number 21	Township number T 27 S	Range number R 1W E/W
2. Distance and direction from nearest town or city: Street address of well location if in city: 150 S. TYLER				3. Owner of well: ROBERT HEFFLEY R.R. or street: 150 S. TYLER City, state, zip code: WICHITA, KS.		
4. Locate with "X" in section below:		Sketch map:		6. Bore hole dia. 11 in. Completion date 9-28-77 Well depth 65 ft.		
				7. Cable tool ☒ Rotary ☐ Driven ☐ Dug ☐ Hollow rod ☐ Jetted ☐ Bored ☐ Reverse rotary		
5. Type and color of material				8. Use: ☒ Domestic ☐ Public supply ☐ Industry ☐ Irrigation ☐ Air conditioning ☐ Stock ☐ Lawn ☐ Oil field water ☐ Other		
				9. Casing: Material Steel Height: Above or below Threaded ☐ Welded ☒ Surface 14 in. RMP ☐ PVC ☐ Weight 1.5 lbs./ft. Dia. 5 in. to 65 ft. depth Wall Thickness: inches or Dia. ☐ in. to ☐ ft. depth gage No. 1 200		
				10. Screen: Manufacturer's name JOHNSON Type 100 Dia. 5" Slot/gauze #12 Length 5' Set between 60 ft. and 65 ft. Gravel pack? YES Size range of material 1/16" - 1/8"		
				11. Static water level: ☐ mo./day/yr. 30 ft. below land surface Date 9-28-77		
				12. Pumping level below land surfaces: 30 ft. after 8 hrs. pumping 15 g.p.m. ft. after ☐ hrs. pumping ☐ g.p.m. Estimated maximum yield 60 g.p.m.		
				13. Water sample submitted: ☐ Yes ☒ No Date ☐		
				14. Well head completion: ☒ Pitless adapter ☐ Inches above grade		
				15. Well grouted? YES With: ☒ Neat cement ☐ Bentonite ☐ Concrete Depth: From 0 ft. to 10 ft.		
				16. Nearest source of possible contamination: ft. 60 Direction W Type SEWER Well disinfected upon completion? ☒ Yes ☐ No		
				17. Pump: Manufacturer's name DUNSTER Not installed Model number DH4052 HP 1 Volts 230 Length of drop pipe 40 ft. capacity 20 g.p.m. Type: ☒ Submersible ☐ Turbine ☐ Jet ☐ Reciprocating ☐ Centrifugal ☐ Other		
(Use a second sheet if needed)						
18. Elevation:		19. Remarks:		20. Water well contractor's certification:		
Topography: ☒ Hill ☒ Slope ☐ Upland ☒ Valley		Customer to pour concrete slab Signature on file		This well was drilled under my jurisdiction and this report is true to the best of my knowledge and belief. 21st Eduardo 129 Business name 512 W. 21st License No. Address J. Harris Date 10-26-77 Signed J. Harris Authorized representative		

Forward the white, blue and pink copies to the Department of Health and Environment

Form WWC-5