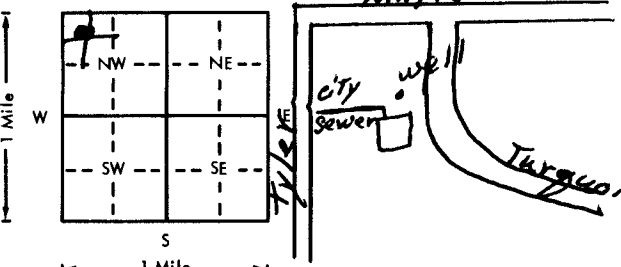


USE TYPEWRITER OR BALL
POINT PEN—PRESS FIRMLY,
PRINT CLEARLY.

WATER WELL RECORD
KSA 82g-1201-1215

Kansas Department of Health and
Environment-Division of Environment
(Water well Contractors)
Topeka, Kansas 66620

SW NE NW NW

County: <u>Sedgwick</u>		Fraction: <u>N 1/4 NW 1/4 NW 1/4</u>	Section number: <u>21</u>	Township number: <u>27</u>	Range number: <u>1</u>
1. Location of well: <u>Sedgwick</u>			3. Owner of well: <u>JACK Sikes Const. Co</u>		
2. Distance and direction from nearest town or city:			R.R. or street: <u>2934 S. Seneca</u>		
Street address of well location if in city: <u>361 Turquoise</u>			City, state, zip code: <u>Wichita KS 67217</u>		
4. Locate with "X" in section below:			6. Bore hole dia. <u>10</u> in. Completion date: <u>6-5-76</u>		
Sketch map:			Well depth <u>47</u> ft.		
			7. Cable tool ☐ Rotary ☐ Driven ☐ Dig ☐ Hollow rod ☐ Jetted ☒ Bored ☐ Reverse rotary ☐		
5. Type and color of material			8. Use: ☒ Domestic ☐ Public supply ☐ Industry ☐ ☐ Irrigation ☐ Air conditioning ☐ Stock ☐ Lawn ☐ Oil field water ☐ Other ☐		
			9. Casing: Material <u>PVC</u> Height: <u>Above</u> or below Threaded ☐ Welded ☐ Surface <u>12</u> in. RMP ☐ PVC ☒ Weight <u>12</u> lbs./ft. Dia. <u>4</u> in. to <u>0</u> ft. depth: Wall Thickness: inches or Dia. <u>4</u> in. to <u>47</u> ft. depth: gage No. <u>1320</u>		
Clay brown			10. Screen: Manufacturer's name <u>Sun Flower</u>		
Clay sandy brown			Type <u>PVC</u> Dia. <u>6"</u>		
Sand Fine to coarse brown			Slot/gauge <u>3/16</u> Length <u>5 ft</u>		
Clay balls yellowish			Set between <u>42</u> ft. and <u>47</u> ft.		
Coarse gravel brown			Gravel pack? ☒ Size range of material _____		
			11. Static water level: _____ mo./day/yr.		
			<u>33</u> ft. below land surface Date <u>6-5-76</u>		
			12. Pumping level below land surfaces:		
			<u>33</u> ft. after <u>1</u> hrs. pumping <u>19</u> g.p.m.		
			_____ ft. after _____ hrs. pumping _____ g.p.m.		
			Estimated maximum yield <u>50</u> g.p.m.		
			13. Water sample submitted: _____ mo./day/yr.		
			Yes ☒ No ☐ Date _____		
			14. Well head completion:		
			☒ Pitless adapter _____ inches above grade		
			15. Well grouted? <u>yes</u>		
			With: <u>Neat cement</u> ☐ Bentonite ☒ Concrete ☐		
			Depth: From <u>2</u> ft. to <u>14</u> ft.		
			16. Nearest source of possible contamination: <u>city sewer</u>		
			ft. <u>11</u> Direction <u>W</u> Type <u>sewer</u>		
			Well disinfected upon completion? ☒ Yes ☐ No ☐		
			17. Pump: _____ Not installed		
			Manufacturer's name <u>Flint & Walling</u>		
			Model number <u>5BK5</u> HP <u>1/2</u> Volts <u>220</u>		
			Length of drop pipe <u>40</u> ft. capacity <u>19</u> g.p.m.		
			Type:		
			☒ Submersible ☐ Turbine		
			☐ Jet ☐ Reciprocating		
			☐ Centrifugal ☐ Other _____		
18. Elevation:			19. Remarks: <u>Concrete slab to be installed after back filled & graded by J.P.F.</u>		
Topography: ☒ Hill ☐ Slope ☐ Upland ☐ Valley			20. Water well contractor's certification:		
			This well was drilled under my jurisdiction and this report is true to the best of my knowledge and belief.		
			<u>Protheroe Pump & Well 295</u>		
			Business name _____ License No. _____		
			Address <u>227 W 27th</u> <u>Wichita KS</u>		
			Signed <u>Protheroe</u> Date <u>6-9-76</u>		
			Authorized representative _____		

Forward the white, blue and pink copies to the Department of Health and Environment

Form WWC-5

MI-1023