USE TYPEWRITER OR BALL POINT PEN-PRESS FIRMLY, PRINT CLEARLY.

WATER WELL RECORD
KSA 82a-1201-1215

Kansas Department of Health and Environment-Division of Environment
(Water well Contractors)
Topeka, Kansas 66620

1. Location of well:	County	Fraction	Section number	Township number	Range number
	Sedgwick	SW 1/4 SW 1/4 SW 1/4	21	T 27 S	R 1 W E/W

2. Distance and direction from nearest town or city:
Street address of well location if in city: Tyler Road & Maple
Wichita, Kansas

3. Owner of well:
R.R. or street: Jerry Seller s
224 South Oliver
City, state, zip code: Wichita, Kansas

4. Locate with "X" in section below: Sketch map:

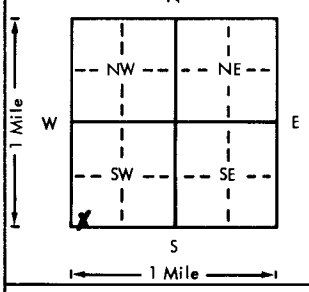

6. Bore hole dia. 11 in. Completion date
Well depth 125 ft. 7-28-77

7. __ Cable tool X Rotary __ Driven __ Dug
__ Hollow rod __ Jetted __ Bored __ Reverse rotary

8. Use: __ Domestic __ Public supply __ Industry
__ Irrigation X Air conditioning __ Stock
__ Lawn __ Oil field water __ Other

9. Casing: Material styrene Height: Above or ~~below~~
Threaded ___ Welded gl Surface 12 in.
RMP X PVC ___ Weight ___ lbs./ft.
Dia. 5 in. to 125 ft. depth Wall Thickness: inches or
Dia. ___ in. to ___ ft. depth gage No. .200

5. Type and color of material	From	To
Topsoil	0	3
Sandy Clay	3	15
Fine Sand with Clay Streaks	15	25
Fine Sand	25	35
Medium Sand	35	50
Clay	50	85
Fine Sand with Clay Streaks	85	96
Medium Sand to coarse Sand	96	108
Coarse Sand with Some Fine Gravel	108	125
(Use a second sheet if needed)		

10. Screen: Manufacturer's nome
Sunflower Plastiac
Type styrene Dia. 5"
Slot/~~gauze~~ 06 Length 20'
Set between 105 ft. and 125 ft.
___ ft. and ___ ft.
Gravel pack? ~~yes~~ Size range of material ~~1-1/8"~~ 1/4-1/8"

11. Static water level: mo./day/yr.
30 ft. below land surface Date 7-28-77

12. Pumping level below land surfaces:
___ ft. after ___ hrs. pumping ___ g.p.m.
___ ft. after ___ hrs. pumping ___ g.p.m.
Estimated maximum yield ___ g.p.m.

13. Water sample submitted: mo./day/yr.
___ Yes ___ No Date ___

14. Well head completion: well seal
___ Pitless adapter 12 Inches above grade

15. Well grouted? ~~yes~~ 1 to 2 fine sand
With: ___ Neat cement ___ ~~Bentonite~~ Mix X Concrete
Depth: From 0 ft. to 10 ft.

16. Nearest source of possible contamination: City Sewer
ft. 100 Direction North Type line
Well disinfected upon completion? X Yes ___ No

17. Pump: ___ Not installed
Manufacturer's name Sta-Rite
Model number 20P4Do2P 3/4 Volts 230
Length of drop pipe 50 ft. capacity 20 g.p.m.
Type:
X Submersible ___ Turbine
___ Jet ___ Reciprocating
___ Centrifugal ___ Other

18. Elevation:
Topography:
___ Hill
___ Slope
___ Upland
___ Valley

19. Remarks:
Flat Ground

20. Water well contractor's certification:
This well was drilled under my jurisdiction and this report is true to the best of my knowledge and belief.
Harp Well & Pump 236
Business name License No.
Address Wichita, Kansas 67209
Signed M. Arnold Date
Authorized representative 8-1-77

T 27 R 1 W E/W Sec 21 1/4 1/4 1/4 SW SW

Forward the white, blue and pink copies to the Department of Health and Environment

Form WWC-5

MI-1023