USE TYPEWRITER OR BALL POINT PEN-PRESS FIRMLY, PRINT CLEARLY.

WATER WELL RECORD
KSA 82a-1201-1215

Kansas Department of Health and Environment-Division of Environment
(Water well Contractors)
Topeka, Kansas 66620

SW NW SE SW

1. Location of well: County Sedgwick; Fraction 1/4 SW 1/4 SW 1/4; Section number 21; Township number T 27S S; Range number R 1 E W

2. Distance and direction from nearest town or city: 135 South Socora Drive
Street address of well location if in city: 135 South Socora Drive

3. Owner of well: Randy Hay Construction
R.R. or street: 135 South Socora Drive
City, state, zip code: Wichita, Kansas

4. Locate with "X" in section below: Sketch map: Wichita, Kansas

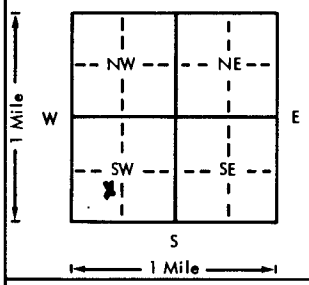

6. Bore hole dia. 11 in. Completion date 6-5-76
Well depth 73 ft.

7. Cable tool ✓ Rotary Driven Dug
Hollow rod Jetted Bored Reverse rotary

8. Use: ✓ Domestic Public supply Industry
Irrigation Air conditioning Stock
Lawn Oil field water Other

9. Casing: Material Steel; Height Above or below
Threaded Welded ✓ Surface 12 in.
RMP ✓ PVC Weight lbs./ft.
Dia. 5 in. to 73 ft. depth Wall Thickness: inches or
Dia. in. to ft. depth gage No. #200

5. Type and color of material	From	To
Sandy Topsoil	0	2
Clay	2	15
Medium Sand	15	73

10. Screen: Manufacturer's name Sunflower Plastics
Type Styrene Dia. 5"
Slot/gauze .06 Length 20'
Set between 53 ft. and 73 ft.
ft. and ft.
Gravel pack? yes Size range of material 1/4-1/8"

11. Static water level: mo./day/yr.
20 ft. below land surface Date 6-5-76

12. Pumping level below land surfaces:
ft. after hrs. pumping g.p.m.
ft. after hrs. pumping g.p.m.
Estimated maximum yield g.p.m.

13. Water sample submitted: mo./day/yr.
Yes No Date

14. Well head completion: Capped
Pitless adapter 12 Inches above grade

15. Well grouted? yes
With: Neat cement Bentonite ✓ Concrete
Depth: From 40 to 14 ft.

16. Nearest source of possible contamination: Cesspool
ft. 50 Direction North Type Sewer
Well disinfected upon completion? ✓ Yes No

17. Pump: ✓ Not installed
Manufacturer's name
Model number HP Volts
Length of drop pipe ft. capacity g.p.m.
Type:
Submersible Turbine
Jet Reciprocating
Centrifugal Other

(Use a second sheet if needed)

18. Elevation:
Topography:
Hill
Slope
Upland
Valley

19. Remarks: Flat Ground
Pump not installed at this time.

20. Water well contractor's certification:
This well was drilled under my jurisdiction and this report is true to the best of my knowledge and belief.
Harp Well & Pump 236
Business name License No.
Address Wichita Kansas
Signed M. Orsall Date 7-30-76
Authorized representative

T 27 R 1 E W Sec 21 1/4 SW 1/4 SW 1/4

Forward the white, blue and pink copies to the Department of Health and Environment

Form WWC-5

MI-1023