


1	LOCATION OF WATER WELL:	Fraction	SW $\frac{1}{4}$	SE $\frac{1}{4}$	SE $\frac{1}{4}$	Section Number	21	Township Number	T 27 S	Range Number	R 1 E
---	-------------------------	----------	------------------	------------------	------------------	----------------	----	-----------------	--------	--------------	-------

Distance and direction from nearest town or city street address or well if located within city?

126 8 Ashby Park

2 WATER WELL OWNER: ms Sanders
RR#, St. Address, Box #: 126 S Ashley Park
City, State, ZIP Code: Wichita Kan 67209
Board of Agriculture, Division of Water Resources
Application Number: none

3 LOCATE WELL'S LOCATION WITH AN "X" IN SECTION BOX: 4 DEPTH OF COMPLETED WELL: 31 3/4 ft. ELEVATION: 1300

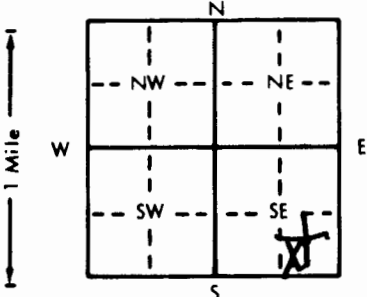

4 DEPTH OF COMPLETED WELL..... 31 31 ft. ELEVATION:..... 1308

Depth(s) Groundwater Encountered 1..... 31 ft. 2..... ft. 3..... ft.

WELL'S STATIC WATER LEVEL 31..... ft. below land surface measured on mo/day/yr 4-30-92

Pump test data: Well water was..... ft. after..... hours pumping..... gpm

Est. Yield..... gpm Well water was..... ft. after..... hours pumping..... gpm

Bore Hole Diameter..... 9..... in. to..... ft., and..... in. to..... ft.

WELL WATER TO BE USED AS:

1 Domestic	3 Feedlot	5 Public water supply	8 Air conditioning	11 Injection well
2 Irrigation	4 Industrial	6 Oil field water supply	9 Dewatering	12 Other (Specify below)
		7 Lawn and garden only	10 Monitoring well	

Was a chemical/bacteriological sample submitted to Department? Yes..... No..... X.....; If yes, mo/day/yr sample was submitted

Water Well Disinfected? Yes..... No..... X

5 TYPE OF BLANK CASING USED:		5 Wrought iron	8 Concrete tile	CASING JOINTS: Glued ☒ Clamped ☐	
1 Steel	3 RMP (SR)	6 Asbestos-Cement	9 Other (specify below)	Welded ☐	
② PVC	4 ABS	7 Fiberglass		Threaded ☐	
Blank casing diameter 5 in. to 41 ft. Dia				in. to ft.	
Casing height above land surface 12 in. weight		lbs./ft. Wall thickness or gauge No. 160			

TYPE OF SCREEN OR PERFORATION MATERIAL:			 PVC	10 Asbestos-cement
1 Steel	3 Stainless steel	5 Fiberglass	8 RMP (SR)	11 Other (specify)
2 Brass	4 Galvanized steel	6 Concrete tile	9 ABS	12 None used (open hole)

SCREEN OR PERFORATION OPENINGS ARE:

1 Continuous slot	3 Mill slot	5 Gauzed wrapped	8 Saw cut	11 None (open hole)
2 Louvered shutter	4 Key punched	6 Wire wrapped	9 Drilled holes	
		7 Torch cut	10 Other (specify)	

SCREEN-PERFORATED INTERVALS:	From 71	ft. to 51	ft., From	ft. to	ft.
	From	ft. to	ft., From	ft. to	ft.
GRAVEL PACK INTERVALS:	From	ft. to	ft., From	ft. to	ft.
	From none	ft. to	ft., From	ft. to	ft.

6. GROUT MATERIAL: 1 Neat cement 2 Cement grout 3 Bentonite 4 Other
Grout Intervals: From 0 ft. to 20 ft., From ft. to ft., From ft. to ft.

What is the nearest source of possible contamination:

1 Septic tank	4 Lateral lines	7 Pit privy	10 Livestock pens	14 Abandoned water well
2 Sewer lines	5 Cess pool	8 Sewage lagoon	11 Fuel storage	15 Oil well/Gas well
3 Watertight sewer lines	6 Seepage pit	9 Feedyard	12 Fertilizer storage	16 Other (specify below)

Direction from well? *South*

How many feet? *25*

[illegible][illegible]

7] CONTRACTOR'S OR LANDOWNER'S CERTIFICATION: This water well was (1) constructed, (2) reconstructed, or (3) plugged under my jurisdiction and was completed on (mo/day/year) 4-30-92 and this record is true to the best of my knowledge and belief. Kansas Water Well Contractor's License No. 472 This Water Well Record was completed on (mo/day/yr) 4-30-93 under the business name of Bearden Pump & Well Serv., by (signature) David R. Bearden