

1 LOCATION OF WATER WELL:		Fraction	Section Number	Township Number	Range Number
County:	SEOGWICK	SW 1/4 SW 1/4 NW 1/4	22	T 27 S	R 1 E


1	LOCATION OF WATER WELL:	Fraction	Section Number	Township Number	Range Number
County:	SEOGWICK	SW 1/4 SW 1/4 NW 1/4	22	T 27 S	R 1 E

Distance and direction from nearest town or city street address of well if located within city?

6801 PAR LANE
2 WATER WELL OWNER: FARMINGTON SD APTS
RR#, St. Address, Box # : 6801 PAR LANE
City, State, ZIP Code : WICHITA KS

Board of Agriculture, Division of Water Resources
Application Number:

3 LOCATE WELL'S LOCATION WITH AN "X" IN SECTION BOX: 4 DEPTH OF COMPLETED WELL: 43 ft. ELEVATION:

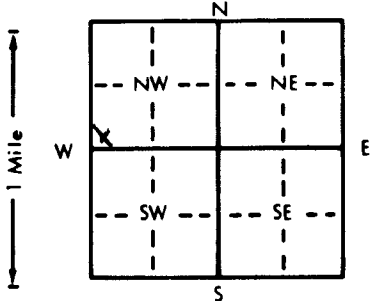

Depth(s) Groundwater Encountered 1. ft. 2. ft. 3. ft.

WELL'S STATIC WATER LEVEL ft. below land surface measured on mo/day/yr

Pump test data: Well water was ft. after hours pumping gpm

Est. Yield gpm: Well water was ft. after hours pumping gpm

Bore Hole Diameter. 8 in. to 43 ft., and in. to ft.

WELL WATER TO BE USED AS:

1 Domestic	3 Feedlot	5 Public water supply	8 Air conditioning	11 Injection well
2 Irrigation	4 Industrial	6 Oil field water supply	9 Dewatering	12 Other (Specify below)
		7 Lawn and garden only	<u>10</u> Monitoring well	

Was a chemical/bacteriological sample submitted to Department? Yes. No. ☒ If yes, mo/day/yr sample was sub-
mitted Water Well Disinfected? Yes No ☒

5 TYPE OF BLANK CASING USED: 5 Wrought iron 8 Concrete tile CASING JOINTS: Glued Clamped
1 Steel 3 RMP (SR) 6 Asbestos-Cement 9 Other (specify below) Welded
2 PVC 4 ABS 7 Fiberglass Threaded. ☒
Blank casing diameter 2 1/2 in. to 33 ft. Dia in. to ft. Dia in. to ft.

Casing height above land surface. 10 in., weight 340 lbs./ft. Wall thickness or gauge No.

TYPE OF SCREEN OR PERFORATION MATERIAL:

1 Steel	3 Stainless steel	5 Fiberglass	8 RMP (SR)	10 Asbestos-cement
2 Brass	4 Galvanized steel	6 Concrete tile	9 ABS	11 Other (specify)
				12 None used (open hole)

SCREEN OR PERFORATION OPENINGS ARE:		5 Gauzed wrapped	8 Saw cut	11 None (open hole)
1 Continuous slot	3 Mill slot	6 Wire wrapped	9 Drilled holes	
2 Louvered shutter	4 Key punched	7 Torch cut	10 Other (specify)	
SCREEN-PERFORATED INTERVALS:	From 33	ft. to 43	ft. From	ft. to
	From	ft. to	ft. From	ft. to
GRAVEL PACK INTERVALS:	From 25	ft. to 43	ft. From	ft. to
	From	ft. to	ft. From	ft. to

6] GROUT MATERIAL: 1 Neat cement 2 Cement grout 3 Bentonite 4 Other VELOCAL

Grout Intervals: From 0 ft. to 25 ft., From _____ ft. to _____ ft., From _____ ft. to _____ ft.

What is the nearest source of possible contamination:

1 Septic tank	4 Lateral lines	7 Pit privy	10 Livestock pens	14 Abandoned water well
2 Sewer lines	5 Cess pool	8 Sewage lagoon	11 Fuel storage	15 Oil well/Gas well
3 Watertight sewer lines	6 Seepage pit	9 Feedyard	12 Fertilizer storage	16 Other (specify below)
			13 Insecticide storage	

Direction from well? W

How many feet? 200

[illegible]

7] CONTRACTOR'S OR LANDOWNER'S CERTIFICATION: This water well was (1) constructed, (2) reconstructed, or (3) plugged under my jurisdiction and was completed on (mo/day/year) 3/27 and this record is true to the best of my knowledge and belief. Kansas Water Well Contractor's License No. 602 This Water Well Record was completed on (mo/day/yr) 4/11/90 under the business name of Rayne Water Co Inc by (signature) Paul H. Meier

INSTRUCTIONS: Use typewriter or ball point pen. PLEASE PRESS FIRMLY and PRINT clearly. Please fill in blanks, underline or circle the correct answers. Send top three copies to Kansas Department of Health and Environment, Bureau of Water Protection, Topeka, Kansas 66620-7320. Telephone: 913-296-5514. Send one to WATER WELL OWNER and retain one for your records.

7E08E02068-