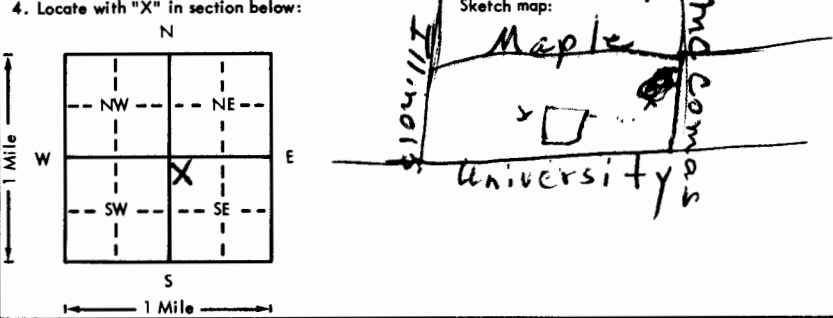


USE TYPEWRITER OR BALL
POINT PEN-PRESS FIRMLY,
PRINT CLEARLY.

WATER WELL RECORD
KSA 82a-1201-1215

Kansas Department of Health and
Environment-Division of Environment
(Water well Contractors)
Topeka, Kansas 66620

SE NWNWNW 25

1. Location of well:		County Sedgwick	Fraction SE 1/4	Section number 25	Township number T 27 S	Range number R 1 E
2. Distance and direction from nearest town or city: Street address of well location if in city: 3824 University			3. Owner of well: LW Black R.R. or street: 171 S. Colorado City, state, zip code: Wichita Kans 67209			
4. Locate with "X" in section below:		Sketch map:			6. Bore hole dia. 35 in. Completion date 10/6/77 Well depth 35 ft.	
					7. ☒ Cable tool ☒ Rotary ☐ Driven ☐ Dug ☐ Hollow rod ☐ Jetted ☐ Bored ☐ Reverse rotary	
5. Type and color of material		From		To		8. Use: ☒ Domestic ☐ Public supply ☐ Industry ☐ Irrigation ☐ Air conditioning ☐ Stock ☐ Lawn ☐ Oil field water ☐ Other
Black top soil		0		5		9. Casing: Material STEEL Height: Above or below Threaded ☐ Welded ☐ Surface 12 in. RMP ☒ PVC ☐ Weight 100 lbs./ft. Dia. 5 in. to 35 ft. depth Wall Thickness: inches or Dia. 5 in. to 35 ft. depth gage No. 100
Brown Sand		5		10		10. Screen: Manufacturer's name SUNFLOWER Type 100 Dia. 5 Slot/gauze 3/64 Length 5 Set between 30 ft. and 35 ft. ft. and 35 ft.
White Sand		10		14		Gravel pack? YES Size range of material 1/2 GRAVEL
Brown & White gravel		14		35		11. Static water level: 16 ft. below land surface Date 10/6/77
						12. Pumping level below land surfaces: ____ ft. after ____ hrs. pumping ____ g.p.m. ____ ft. after ____ hrs. pumping ____ g.p.m. Estimated maximum yield 10 g.p.m.
						13. Water sample submitted: ____ mo./day/yr. Yes ☐ No ☒ Date
						14. Well head completion: Pitless adapter 12 inches above grade
						15. Well grouted? YES With: ☒ Neat cement ☐ Bentonite ☐ Concrete Depth: From 0 ft. to 10 ft.
						16. Nearest source of possible contamination: ft. 30 Direction EAST Type Sewer Well disinfected upon completion? ☒ Yes ☐ No
						17. Pump: ☒ Not installed Manufacturer's name Model number ____ HP ____ Volts ____ Length of drop pipe ____ ft. capacity ____ g.p.m. Type: ☐ Submersible ☐ Turbine ☐ Jet ☐ Reciprocating ☐ Centrifugal ☐ Other
18. Elevation:		19. Remarks:		20. Water well contractor's certification: This well was drilled under my jurisdiction and this report is true to the best of my knowledge and belief. Jet Drilling 313 Business name License No. Address 257 N. Sebin Signed Alvin Anderson Date 10/6/77 Authorized representative		

Forward the white, blue and pink copies to the Department of Health and Environment

Form WWC-5