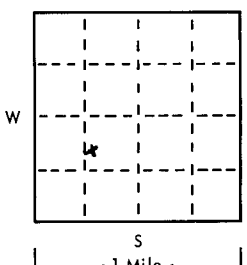
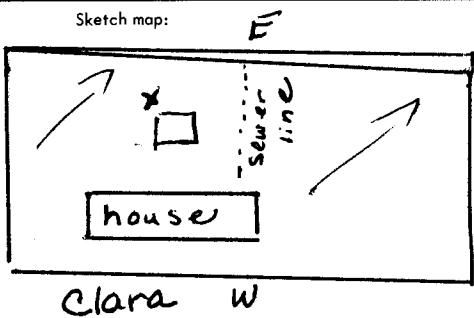


USE TYPEWRITER OR BALL
POINT PEN-PRESS FIRMLY,
PRINT CLEARLY.

WATER WELL RECORD
KSA 82a-1201-1215

T R EW sec 1/4 1/4 1/4 No.

Kansas State Dept. Of Health
(Water Well Contractors)
Forbes-Bldg. 740
Topeka, Kansas 66620

1 Location of well:	County SG	Township name Delano	Fraction SE-NE-SW	Section number 23	Town number T-27 S	Range number R1W
Distance and direction from nearest town or city:			3 Owner of well: Max A. Lee			
Street address of well location if in city: SAME			Address: 134 So. Clara Wichita, Kans. 67209			
Locate with "X" in section below:		Sketch map:		4 Well depth: 35 ft. Date of completion 4-9-76 Well diameter 10 in.		
				5 ☐ Cable tool ☐ Rotary ☐ Driven ☐ Dug ☐ Hollow rod ☐ Jetted ☒ Bored ☐ Reverse rotary		
2 Type and color of material		From	To	6 Use: ☒ Domestic ☐ Public supply ☐ Industry ☐ Irrigation ☐ Air conditioning ☐ Commercial ☐ Test well		
sandy soil		0	4	7 Casing: Material RMP Height: above/below Threading ☐ Welded ☐ Surface 13 in. Diam. 6 in. to 25 ft. depth Drive shoe? ☐ Yes ☒ No		
brown clay		4	11	8 Screen: Manufacturer Sunflower Type RMP Dia. 6" Slot/gauze .075 x 2" Length Set between 25 ft. and 35 ft.		
sand		11	15	Fittings: Gravel pack ☐ Yes ☒ No Size range of material		
gray clay		15	16	9 Static water level: 16 ft. below land surface Date 4-9-76		
course sand		16	35	10 Pumping level below land surfaces: ____ ft. after ____ hrs. pumping ____ g.p.m. ____ ft. after ____ hrs. pumping ____ g.p.m. Estimated maximum yield ____ g.p.m.		
				11 Water sample submitted: ☐ Yes ☒ No Date		
				12 Well head completion: ☐ Pitless adapter ☒ Inches above grade		
				13 Well grouted? ☒ Yes ☐ No ☒ Neat cement ☐ Bentonite ☐ Depth: From 0 ft. to 10 ft.		
				14 Nearest source of possible contamination: sewer line ft. 30 Direction S Type line Well disinfected upon completion? ☒ Yes ☐ No		
				15 Pump: ☒ Not installed Manufacturer's name Model number ____ HP ____ Volts ____ Length of drop pipe ____ ft. capacity ____ g.m.p. Type: ☐ Submersible ☐ Turbine ☐ Jet ☐ Reciprocating ☐ Centrifugal ☐ Other		
16 Remarks: elevation		17 Water well contractor's certification: This well was drilled under my jurisdiction and this report is true to the best of my knowledge and belief. Whitchurch Well Service 309 Business name License No. Address 520 James St. Signed [Signature] Date 4-25-76 Authorized representative				

Forward the white, blue and pink copies to the Kansas State Dept. Of Health.

Form WWC-5