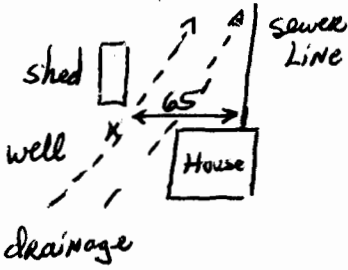


USE TYPEWRITER OR BALL
POINT PEN-PRESS FIRMLY,
PRINT CLEARLY.

WATER WELL RECORD
KSA 82a-1201-1215

T R EW sec 1/4 1/4 1/4 No.

Kansas State Dept. Of Health
(Water Well Contractors)
Forbes-Bldg. 740
Topeka, Kansas 66620

1 Location of well:	County <u>Sedgwick</u>	Township name <u>Delano</u>	Fraction <u>SE-NE-SW</u>	Section number <u>23</u>	Town number <u>T27S</u>	Range number <u>R1W</u>
Distance and direction from nearest town or city: Street address of well location if in city: <u>144 S. CLARA Wichita</u>				3 Owner of well: <u>Cecil H. Foster</u> Address: <u>144 S. CLARA Wichita, Kans.</u>		
Locate with "X" in section below: N W E S 1 Mile				Sketch map: 		
2 Type and color of material				From	To	4 Well depth: <u>30</u> ft. Date of completion <u>8-1-75</u> Well diameter <u>10</u> in.
<u>sandy soil</u>				<u>0</u>	<u>4</u>	5 ☒ Cable tool ☐ Rotary ☐ Driven ☐ Dug ☐ Hollow rod ☐ Jetted ☐ Bored ☐ Reverse rotary
<u>brown clay</u>				<u>4</u>	<u>11</u>	6 Use: ☒ Domestic ☐ Public supply ☐ Industry ☐ Irrigation ☐ Air conditioning ☐ Commercial ☐ Test well ☐
<u>sand</u>				<u>11</u>	<u>15</u>	7 Casing: Material <u>plastic</u> Height: <u>above</u> below Threaded ☐ Welded ☒ Surface <u>13</u> in. Diam. <u>RMP 4</u> Weight <u>6</u> lbs./ft. <u>6</u> in. to <u>20</u> ft. depth Drive shoe? ☐ Yes ☒ No <u>6</u> in. to <u>6</u> ft. depth
<u>gray clay</u>				<u>15</u>	<u>16</u>	8 Screen: Manufacturer <u>sun flower</u> Type <u>Jet-set 100 RMP</u> Dia. <u>6</u> Slot gauge <u>1/16</u> Length <u>10</u> Set between <u>20</u> ft. and <u>30</u> ft. Fittings: Gravel pack ☐ Yes ☒ No Size range of material <u> </u>
<u>coarse sand</u>				<u>16</u>	<u>30</u>	9 Static water level: <u>11</u> ft. below land surface Date <u>7-31-75</u>
						10 Pumping level below land surfaces: ____ ft. after ____ hrs. pumping ____ g.p.m. ____ ft. after ____ hrs. pumping ____ g.p.m. Estimated maximum yield ____ g.p.m.
						11 Water sample submitted: ☐ Yes ☒ No Date <u> </u>
						12 Well head completion: <u>13</u> ☐ Pitless adapter ☐ Inches above grade
						13 Well grouted? ☒ Yes ☐ No ☐ Neat cement ☐ Bentonite ☒ <u>portland</u> Depth: From <u>0</u> ft. to <u>10</u> ft. <u>cement</u>
						14 Nearest source of possible contamination: <u>Sewer</u> ft. <u>65</u> Direction <u>S</u> Type <u>line</u> Well disinfected upon completion? ☒ Yes ☐ No
						15 Pump: ☒ Not installed Manufacturer's name <u> </u> Model number <u> </u> HP <u> </u> Volts <u> </u> Length of drop pipe <u> </u> ft. capacity <u> </u> g.p.m. Type: ☐ Submersible ☐ Turbine ☐ Jet ☐ Reciprocating ☐ Centrifugal ☐ Other
16 Remarks: elevation Topography: ☐ Hill ☐ Slope ☒ Upland ☐ Valley				17 Water well contractor's certification: This well was drilled under my jurisdiction and this report is true to the best of my knowledge and belief. <u>Whitchurch Well Service 309</u> Business name License No. <u> </u> Address <u>520 James Maize, Ks.</u> Signed <u>Joe W. Whitchurch</u> Date <u>8-15-75</u> Authorized representative		

Forward the white, blue and pink copies to the Kansas State Dept. Of Health.

Form WWC-5