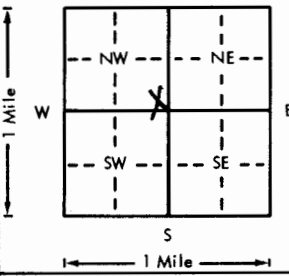
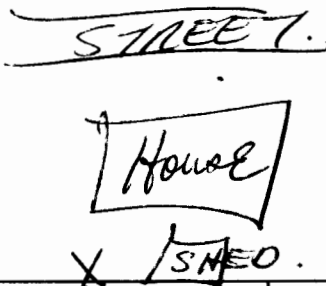


USE TYPEWRITER OR BALL
POINT PEN-PRESS FIRMLY,
PRINT CLEARLY.

WATER WELL RECORD
KSA 82a-1201-1215

Kansas Department of Health and
Environment-Division of Environment
(Water well Contractors)
Topeka, Kansas 66620

1. Location of well: County <u>Sedgwick</u>		Fraction <u>SE 1/4 SW 1/4 NW 1/4</u>	Section number <u>23</u>	Township number <u>T 27 S</u>	Range number <u>R 10 W</u>
2. Distance and direction from nearest town or city: Street address of well location if in city: <u>225 S. CHINA</u>			3. Owner of well: <u>R.E. Lee</u> R.R. or street: <u>225 S. CHINA</u> City, state, zip code: <u>WICHITA, KS.</u>		
4. Locate with "X" in section below: 		Sketch map: 		6. Bore hole dia. <u>10</u> in. Completion date <u>5-1-79</u> Well depth <u>28</u> ft.	
5. Type and color of material		From	To	7. Cable tool ☐ Rotary ☐ Driven ☐ Dug ☐ ☐ Hollow rod ☐ Jetted ☒ Bored ☐ Reverse rotary	
<u>topsoil</u>		<u>0</u>	<u>11</u>	8. Use: ☐ Domestic ☐ Public supply ☐ Industry ☐ ☐ Irrigation ☐ Air conditioning ☐ Stock ☒ Lawn ☐ Oil field water ☐ Other	
<u>med. sand</u>		<u>12</u>	<u>18</u>	9. Casing: Material <u>PVC</u> Height: Above or below Threaded ☐ Welded ☐ Surface <u>12</u> in. RMP ☐ PVC ☒ Weight <u>250</u> lbs./ft. Dia. <u>3</u> in. to <u>28</u> ft. depth Wall thickness: inches <u>1/2</u> Dia. <u>3</u> in. to <u>28</u> ft. depth gage No. <u>1258</u>	
<u>med. gravel</u>		<u>19</u>	<u>28</u>	10. Screen: Manufacturer's name <u>Modern Pipe Co.</u> Type <u>WE</u> Dia. <u>5.563</u> Slot/gauze <u>.025</u> Length <u>58</u> Set between <u>23</u> ft. and <u>28</u> ft. ft. and ft. Gravel pack? <u>No</u> Size range of material	
				11. Static water level: <u>14</u> ft. below land surface Date <u>5-1-79</u> mo./day/yr.	
				12. Pumping level below land surfaces: <u>15</u> ft. after <u>1</u> hrs. pumping <u>15</u> g.p.m. ft. after hrs. pumping g.p.m. Estimated maximum yield <u>30</u> g.p.m.	
				13. Water sample submitted: <u>Yes</u> ☒ No ☐ Date	
				14. Well head completion: <u>12</u> inches above grade ☐ Pitless adapter	
				15. Well grouted <u>YES</u> With: ☒ Neat cement ☐ Bentonite ☐ Concrete Depth: From <u>0</u> ft. to <u>10</u> ft.	
				16. Nearest source of possible contamination: <u>30</u> ft. Direction <u>NE</u> Type <u>SPUR</u> Well disinfected upon completion? <u>Yes</u> ☒ No ☐	
				17. Pump: ☒ Not installed Manufacturer's name Model number HP Volts Length of drop pipe ft. capacity g.p.m. Type: ☐ Submersible ☐ Turbine ☐ Jet ☐ Reciprocating ☐ Centrifugal ☐ Other	
18. Elevation:		19. Remarks:		20. Water well contractor's certification: This well was drilled under my jurisdiction and this report is true to the best of my knowledge and belief. <u>21st Electric</u> <u>129</u> Business name License No. Address <u>512 W. 21st</u> Signed <u>J. Davis</u> Date <u>5-30-79</u> Authorized representative	

Forward the white, blue and pink copies to the Department of Health and Environment

Form WWC-5