

1 LOCATION OF WATER WELL:	Fraction <u>NW 1/4 SE NW 1/4</u>	Section Number <u>24</u>	Township Number <u>27</u>	Range Number <u>1</u>
---------------------------	----------------------------------	--------------------------	---------------------------	-----------------------

Distance and direction from nearest town or city street address of well if located within city?

2 WATER WELL OWNER:

RR#, St. Address, Box #:

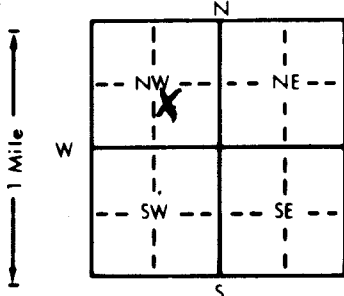
City, State, ZIP Code:

Bob BequetteBox 145B Mthw 1567108

Board of Agriculture, Division of Water Resources

Application Number:

3 LOCATE WELL'S LOCATION WITH AN "X" IN SECTION BOX:

4 DEPTH OF COMPLETED WELL: 50 ft. ELEVATION:Depth(s) Groundwater Encountered 1. 16 ft. 2. 16 ft. 3. 10-31-84 ft.WELL'S STATIC WATER LEVEL 16 ft. below land surface measured on mo/day/yr 10-31-84Pump test data: Well water was 16 ft. after 20 hours pumping 20 gpmEst. Yield 50 gpm: Well water was 16 ft. after 20 hours pumping 20 gpmBore Hole Diameter 11 in. to 50 ft. and 50 in. to 50 ft.

WELL WATER TO BE USED AS:

1 Domestic	3 Feedlot	6 Oil field water supply	9 Dewatering	12 Other (Specify below)
<u>2 Irrigation</u>	4 Industrial	7 Lawn and garden only	10 Observation well	

Was a chemical/bacteriological sample submitted to Department? Yes X No X If yes, mo/day/yr sample was sub-

mitted

Water Well Disinfected? Yes X No X

5 TYPE OF BLANK CASING USED:

1 Steel	<u>3 RMP (SRI)</u>
2 PVC	<u>4 ABS</u>

5 Wrought iron	8 Concrete tile
6 Asbestos-Cement	9 Other (specify below)
7 Fiberglass	

CASING JOINTS: Glued <u>X</u> Clamped
Welded
Threaded

Blank casing diameter 5 in. to 40 ft. Dia. 12 in. to 1.59 lbs./ft. Wall thickness or gauge No. SDR-26Casing height above land surface 12 in. weight 1.59 lbs./ft.

TYPE OF SCREEN OR PERFORATION MATERIAL:

1 Steel	3 Stainless steel
2 Brass	4 Galvanized steel

5 Fiberglass	<u>8 RMP (SRI)</u>
6 Concrete tile	9 ABS

7 PVC	10 Asbestos-cement
11 Other (specify)	12 None used (open hole)

SCREEN OR PERFORATION OPENINGS ARE:

1 Continuous slot	<u>3 Mill slot</u>
2 Louvered shutter	4 Key punched

5 Gauzed wrapped	8 Saw cut
6 Wire wrapped	9 Drilled holes
7 Torch cut	10 Other (specify)

11 None (open hole)

SCREEN-PERFORATED INTERVALS: From 40 ft. to 50 ft. From 50 ft. to 50 ft.GRAVEL PACK INTERVALS: From 10 ft. to 50 ft. From 50 ft. to 50 ft.

6 GROUT MATERIAL:

1 Neat cement	<u>2 Cement grout</u>	3 Bentonite	4 Other
---------------	-----------------------	-------------	---------

Grout Intervals: From 0 ft. to 10 ft. From 10 ft. to 50 ft. From 50 ft. to 50 ft.

What is the nearest source of possible contamination:

1 Septic tank	4 Lateral lines	7 Pit privy
<u>2 Sewer lines</u>	5 Cess pool	8 Sewage lagoon
3 Watertight sewer lines	6 Sewage pit	9 Feedyard

10 Livestock pens	14 Abandoned water well
11 Fuel storage	15 Oil well/Gas well
12 Fertilizer storage	16 Other (specify below)
13 Insecticide storage	

Direction from well?

West

FROM	TO	LITHOLOGIC LOG	FROM	TO	LITHOLOGIC LOG
0	2	Top soil			
2	13	clay			
13	30	fine sand			
30	31	clay			
31	50	sand			

7 CONTRACTOR'S OR LANDOWNER'S CERTIFICATION: This water well was (1) constructed, (2) reconstructed, or (3) plugged under my jurisdiction and was completed on (mo/day/year) 10-31-84 and this record is true to the best of my knowledge and belief. KansasWater Well Contractor's License No. 318 This Water Well Record was completed on (mo/day/yr) 11-5-84under the business name of Weninger Drilling by (signature) Weninger

INSTRUCTIONS: Use typewriter or ball point pen, PLEASE PRESS FIRMLY and PRINT clearly. Please fill in blanks, underline or circle the correct answers. Send top three copies to Kansas Department of Health and Environment, Division of Environment, Environmental Geology Section, Topeka, KS 66620. Send one to WATER WELL OWNER and retain one for your records.

OFFICE USE ONLY

T

27

R

1

EW

SEC.

24

NW

1/4

SE

1/4

NW

1/4