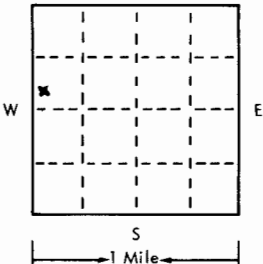
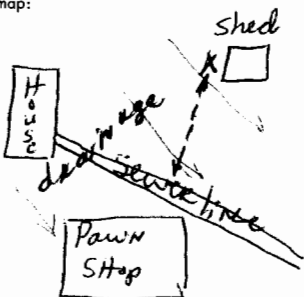


USE TYPEWRITER OR BALL
POINT PEN-PRESS FIRMLY,
PRINT CLEARLY.

WATER WELL RECORD
KSA 82a-1201-1215

27 1 W 2 4 S W M
T R EW sec 1/4 1/4 1/4 No.

Kansas State Dept. Of Health
(Water Well Contractors)
Forbes-Bldg. 740
Topeka, Kansas 66620

1 Location of well:	County Sedg.	Township name Delano	Fraction SW-SW-NW	Section number 24	Town number T27S	Range number R1W		
Distance and direction from nearest town or city: Street address of well location if in city: 438 N. West St. Wichita, Kans.			3 Owner of well: Bert Hook Address: 438 N. West St. Wichita, Kans.					
Locate with "X" in section below: 			Sketch map: 			4 Well depth: 38 ft. Date of completion 7-29-75 Well diameter 6 in.		
2 Type and color of material			From	To	5 ☒ Auger tool ☐ Rotary ☐ Driven ☐ Dug ☐ Hollow rod ☐ Jetted ☒ Bored ☐ Reverse rotary			
			Black dirt		0	3	6 Use: ☒ Domestic ☐ Public supply ☐ Industry ☐ Irrigation ☐ Air conditioning ☐ Commercial ☐ Test well ☐	
			brown clay		3	9	7 Casing: Material PITS Height: above below Threaded ☐ Welded ☒ Surface 13 in. Digm. RMP Weight 1000 lbs. 6 in. to 18 ft. depth Drive shoe? ☐ Yes ☒ No ___ in. to ___ ft. depth	
			fine sand		9	20	8 Screen: Sunflower Manufacturer RMP Type Jet-Set 100 Dia. 6" Set between 18 ft. and 38 ft. Length 20' Fittings: Gravel pack ☐ Yes ☒ No Size range of material ___	
			gray clay		20	22	9 Static water level: 12 ft. below land surface Date 7-28-75	
course sand			22	38	10 Pumping level below land surfaces: ___ ft. after ___ hrs. pumping ___ g.p.m. ___ ft. after ___ hrs. pumping ___ g.p.m. Estimated maximum yield ___ g.p.m.			
(use a second sheet if needed)					11 Water sample submitted: ☐ Yes ☒ No Date ___			
16 Remarks: elevation Topography: ☐ Hill ☐ Slope ☒ Upland ☐ Valley concrete slab to be installed by customer at surface of ground. He knows this is a regulation					12 Well head completion: 13" ☐ Pitless adapter ☐ Inches above grade			
					13 Well grouted? ☒ Yes ☐ No ☐ Neat cement ☐ Bentonite ☒ portland Depth: From 0 ft. to 10 ft. Cement			
					14 Nearest source of possible contamination: sewer ft. 35 Direction SE Type line Well disinfected upon completion? ☒ Yes ☐ No			
					15 Pump: ☒ Not installed Manufacturer's name ___ Model number ___ HP ___ Volts ___ Length of drop pipe ___ ft. capacity ___ g.m.p. Type: ☐ Submersible ☐ Turbine ☐ Jet ☐ Reciprocating ☐ Centrifugal ☐ Other			
					17 Water well contractor's certification: This well was drilled under my jurisdiction and this report is true to the best of my knowledge and belief. Whitchurch Well Service 309 Business name License No. ___ Address 520 James M. J. 2c, Kans. Signed Sam W. Whitchurch Date 8-15-75 Authorized representative			

Forward the white, blue and pink copies to the Kansas State Dept. Of Health.

Form WWC-5