USE TYPEWRITER OR BALL POINT PEN-PRESS FIRMLY, PRINT CLEARLY.

WATER WELL RECORD
KSA 82a-1201-1215

Kansas Department of Health and Environment-Division of Environment
(Water well Contractors)
Topeka, Kansas 66620

1. Location of well:	County: Sedgwick	Fraction: NE 1/4 SW 1/4 NW 1/4	Section number: 24	Township number: T 27 S	Range number: R 1W E/W

2. Distance and direction from nearest town or city:
Street address of well location if in city: 206 ALVENA

3. Owner of well: JESSE A. CAMENER
R.R. or street: 206 ALVENA
City, state, zip code: WICHITA, KS. 67204

4. Locate with "X" in section below:

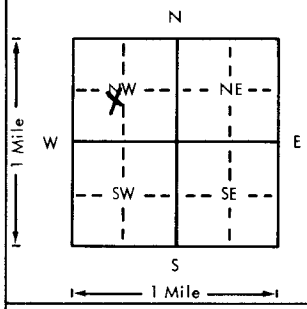

Sketch map:

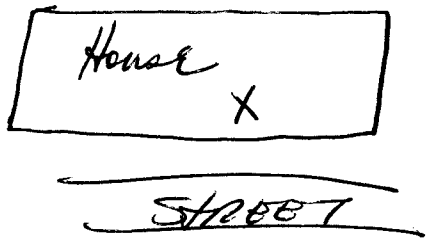

5. Type and color of material	From	To
Topsoil	0	8
Sand	9	15
Gravel	16	20

(Use a second sheet if needed)

6. Bore hole dia. 11 in. Completion date 8-1-79
Well depth 20 ft.

7. __ Cable tool __ Rotary __ Driven __ Dug
__ Hollow rod __ Jetted X Bored __ Reverse rotary

8. Use: __ Domestic __ Public supply __ Industry
__ Irrigation __ Air conditioning __ Stock
X Lawn __ Oil field water __ Other

9. Casing: Material PVC
Threaded ___ Welded ___
RMP ___ PVC X
Dia. 5 in. to 20 ft. depth
Dia. ___ in. to ___ ft. depth
Height: Above or below Surface 12 in.
Weight 2.758 lbs./ft.
Wall Thickness: inches or gage No. .258

10. Screen: Manufacturer's name Modern Well Co.
Type PVC Dia. 5.563
Slot/gauze .025 Length 5'
Set between 15 ft. and 20 ft.
___ ft. and ___ ft.
Gravel pack? NO Size range of material ___

11. Static water level: mo./day/yr.
13 ft. below land surface Date 8-1-79

12. Pumping level below land surfaces:
13 ft. after 1 hrs. pumping 15 g.p.m.
___ ft. after ___ hrs. pumping ___ g.p.m.
Estimated maximum yield 50 g.p.m.

13. Water sample submitted: mo./day/yr.
__ Yes X No Date ___

14. Well head completion:
__ Pitless adapter 12 Inches above grade

15. Well grouted? YES
With: (Neat cement) __ Bentonite __ Concrete
Depth: From 0 ft. to 10 ft.

16. Nearest source of possible contamination:
ft. 25 Direction N Type Sewer
Well disinfected upon completion? (Yes) __ No

17. Pump: __ Not installed
Manufacturer's name Deepwell
Model number HP3752 HP 3/4 Volts 230
Length of drop pipe ___ ft. capacity ___ g.p.m.
Type:
X Submersible __ Turbine
__ Jet __ Reciprocating
__ Centrifugal __ Other

18. Elevation:
Topography:
__ Hill
__ Slope
__ Upland
X Valley

19. Remarks: WELL in basement

20. Water well contractor's certification:
This well was drilled under my jurisdiction and this report is true to the best of my knowledge and belief.
2151 Electric Inc. 129
Business name License No.
Address 512 W. 21 / Wichita KS.
Signed J. Harris Date 8-17-79
Authorized representative

T 27 — R 1 (E/W) — Sec 24 — 1/4 NE 1/4 SW 1/4 NW 1/4

Forward the white, blue and pink copies to the Department of Health and Environment

Farm WWC-5

MI-1023