WATER WELL RECORD Form WWC-5 KSA 82a-1212 2

1 LOCATION OF WATER WELL: County: SEDWICK	Fraction: SE ¼ SW ¼ NW ¼	Section Number: 25	Township Number: T 27 S	Range Number: R 1 E (W)

Distance and direction from nearest town or city street address of well if located within city? 120' NORTH OF 3506 W. HARRY ST.

2 WATER WELL OWNER: SISCO, INC.
RR#, St. Address, Box # : 3506 W. HARRY
City, State, ZIP Code : WICHITA, KS 67213

Board of Agriculture, Division of Water Resources Application Number:

3 LOCATE WELL'S LOCATION WITH AN "X" IN SECTION BOX:

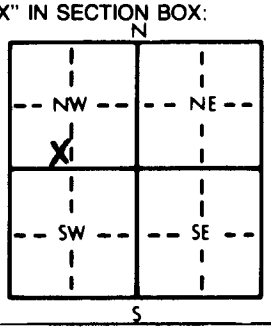

4 DEPTH OF COMPLETED WELL 20.0 ft. ELEVATION:
Depth(s) Groundwater Encountered 1. 14.0 ft. 2. — ft. 3. — ft.
WELL'S STATIC WATER LEVEL 11.93 ft. below land surface measured on mo/day/yr 04-12-94
Pump test data: Well water was — ft. after — hours pumping — gpm
Est. Yield — gpm: Well water was — ft. after — hours pumping — gpm
Bore Hole Diameter 8" in. to 20.0' ft., and — in. to — ft.
WELL WATER TO BE USED AS: 5 Public water supply 8 Air conditioning 11 Injection well
1 Domestic 3 Feedlot 6 Oil field water supply 9 Dewatering 12 Other (Specify below)
2 Irrigation 4 Industrial 7 Lawn and garden only (10) Monitoring well MW-2
Was a chemical/bacteriological sample submitted to Department? Yes ..... No X ; If yes, mo/day/yr sample was submitted
Water Well Disinfected? Yes No X

5 TYPE OF BLANK CASING USED: 5 Wrought iron 8 Concrete tile CASING JOINTS: Glued Clamped
1 Steel 3 RMP (SR) 6 Asbestos-Cement 9 Other (specify below) Welded
(2) PVC 4 ABS 7 Fiberglass Threaded X
Blank casing diameter 2" in. to 19.5' ft., Dia — in. to — ft., Dia — in. to — ft.
Casing height above land surface FLUSH WAIVER in., weight — lbs./ft. Wall thickness or gauge No. 40
TYPE OF SCREEN OR PERFORATION MATERIAL: (7) PVC 10 Asbestos-cement
1 Steel 3 Stainless steel 5 Fiberglass 8 RMP (SR) 11 Other (specify)
2 Brass 4 Galvanized steel 6 Concrete tile 9 ABS 12 None used (open hole)
SCREEN OR PERFORATION OPENINGS ARE: 5 Gauzed wrapped 8 Saw cut 11 None (open hole)
1 Continuous slot (3) Mill slot 6 Wire wrapped 9 Drilled holes
2 Louvered shutter 4 Key punched 7 Torch cut 10 Other (specify)
SCREEN-PERFORATED INTERVALS: From 19.5' ft. to 9.5' ft., From — ft. to — ft.
From — ft. to — ft., From — ft. to — ft.
GRAVEL PACK INTERVALS: From 20.0' ft. to 7.5' ft., From — ft. to — ft.
From — ft. to — ft., From — ft. to — ft.

6 GROUT MATERIAL: (1) Neat cement 2 Cement grout (3) Bentonite 4 Other —
Grout Intervals: From 7.5' ft. to SURFACE ft., From — ft. to — ft., From — ft. to — ft.
What is the nearest source of possible contamination: 10 Livestock pens 14 Abandoned water well
1 Septic tank 4 Lateral lines 7 Pit privy (11) Fuel storage (FORMER) 15 Oil well/Gas well
2 Sewer lines 5 Cess pool 8 Sewage lagoon 12 Fertilizer storage 16 Other (specify below)
3 Watertight sewer lines 6 Seepage pit 9 Feedyard 13 Insecticide storage
Direction from well? NW How many feet? 25'

FROM	TO	LITHOLOGIC LOG	FROM	TO	PLUGGING INTERVALS
Ø	.5	CONCRETE			
.5	3.0	FILL SAND			
3.0	6.5	DK. BROWN SILTYCLAY, FIRM			
6.5	9.5	BROWN SANDY SILTYCLAY, FIRM			
9.5	15.0	LT. BROWN FINE GRAIN SAND, WET 14.0			
15.0	20.0	LT. BROWN MED. GRAIN SAND, WET			
	20.0	TOTAL DEPTH			

7 CONTRACTOR'S OR LANDOWNER'S CERTIFICATION: This water well was (1) constructed, (2) reconstructed, or (3) plugged under my jurisdiction and was completed on (mo/day/year) 3/2/94 and this record is true to the best of my knowledge and belief. Kansas Water Well Contractor's License No. 479 This Water Well Record was completed on (mo/day/yr) 4/1/94 under the business name of ~~ASSOCIATED ENVIRONMENTAL, INC.~~ EBBERTS DRILLING by (signature) Morgan Ebberts 04-27-94

INSTRUCTIONS: Use typewriter or ball point pen. ~~PLEASE PRESS FIRMLY~~ and ~~PRINT~~ clearly. Please fill in blanks, underline or circle the correct answers. Send top three copies to Kansas Department of Health and Environment, Bureau of Water, Topeka, Kansas 66620-0001. Telephone: 913-296-5545. Send one to WATER WELL OWNER and retain one for your records.

OFFICE USE ONLY T R E/W SEC. ¼ ¼ ¼