USE TYPEWRITER OR BALL POINT PEN-PRESS FIRMLY, PRINT CLEARLY.

WATER WELL RECORD
KSA 82a-1201-1215

Kansas Department of Health and Environment-Division of Environment
(Water well Contractors)
Topeka, Kansas 66620

1. Location of well:	County	Fraction	Section number	Township number	Range number
X	Sedgwick	1/4 NW 1/4 NW 1/4	25	T 27 S	R 1W E/W

2. Distance and direction from nearest town or city:
Street address of well location if in city: 307 S. McComas Wichita, Kansas

3. Owner of well: Dave Rush
R.R. or street: 307 S. McComas
City, state, zip code: Wichita, Kansas

4. Locote with "X" in section below:

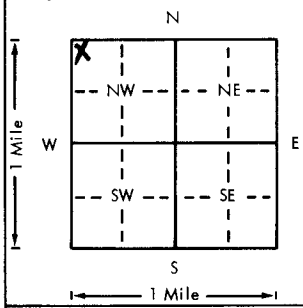

Sketch map:

5. Type and color of material	From	To
Topsoil	0	3
Brown clay	3	12
Fine sand	12	25
Coarse sand	25	59
Yellowish brown clay	59	61
Medium sand	61	65
(Use a second sheet if needed)		

6. Bore hole dia. 11 in. Completion date
Well depth 65 ft. 8-24-78

7. __ Cable tool X Rotary __ Driven __ Dug
__ Hollow rod __ Jetted __ Bored __ Reverse rotary

8. Use: X Domestic __ Public supply __ Industry
__ Irrigotion __ Air conditioning __ Stock
__ Lawn __ Oil field water __ Other

9. Casing: Material Styrene Height: Above or below
Threaded __ Welded gl Surface 12 in.
RMP X PVC __ Weight __ lbs./ft.
Dia. 5 in. to 65 ft. depth Wall Thickness: inches or
Dia. __ in. to __ ft. depth gage No. .200

10. Screen: Manufacturer's name Sunflower plastic
Type Styrene Dia. 5"
Slot/gauge .06 Length 20'
Set between 45 ft. and 65 ft.
__ ft. and __ ft.
Gravel pack? yes Size range of material 1/4-1/8"

11. Static water level: mo./day/yr.
17 ft. below land surface Date 8-24-78

12. Pumping level below land surfaces:
__ ft. after __ hrs. pumping __ g.p.m.
__ ft. after __ hrs. pumping __ g.p.m.
Estimated maximum yield __ g.p.m.

13. Water sample submitted: mo./day/yr.
__ Yes __ No Date

14. Well head completion: capped
__ Pitless adapter 18 Inches above grade

15. Well grouted? yes 1-2fine sand mix
With: __ Neat cement __ Bentonite X Concrete
Depth: From 40" ft. to 14 ft.

16. Nearest source of possible contamination:
ft. 50 Direction West Type City Sewer
Well disinfected upon completion? X Yes Line No

17. Pump: X Not installed
Manufacturer's name
Model number HP Volts
Length of drop pipe ft. capacity g.p.m.
Type:
__ Submersible __ Turbine
__ Jet __ Reciprocating
__ Centrifugal __ Other

18. Elevation:
Topography:
__ Hill
__ Slope
__ Upland
__ Valley

19. Remarks:
Flat ground

20. Water well contractor's certification:
This well was drilled under my jurisdiction and this report is true to the best of my knowledge and belief.
Harp Well & Pump 236
Business name License No.
Address Wichita, Kansas 67209
Signed M. Arnold Date 10-3-78
Authorized representative

27 T 1 R (W) E 25 Sec NW 1/4 NW 1/4 NW 1/4

Forward the white, blue and pink copies to the Department of Health and Environment

Form WWC-5

MI-1023