USE TYPEWRITER OR BALL POINT PEN-PRESS FIRMLY, PRINT CLEARLY.

WATER WELL RECORD
KSA 82a-1201-1215

Kansas Department of Health and Environment-Division of Environment
(Water well Contractors)
Topeka, Kansas 66620

Billed To: Twenty First Electric

1. Location of well:	County	Fraction	Section number	Township number	Ronge number
	Sedgwick	1/4 SE 1/4 NE 1/4	26	T 27 S	R 1 W

2. Distance and direction from nearest town or city:
Street address of well location if in city: 510 S. Florence Wichita, Kansas

3. Owner of well: Rand Publishing Company
R.R. or street: 510 South Florence
City, state, zip code: Wichita, Kansas 67209

4. Locate with "X" in section below: Sketch map:

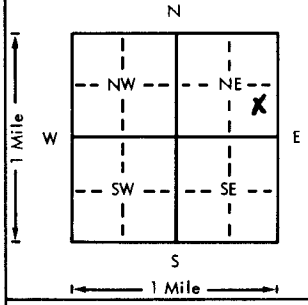

5. Type and color of material	From	To
Sandy Soil	0	2
Clay	2	7
Medium Sand	7	45
(Use a second sheet if needed)		

6. Bore hole dia. 11 in. Completion date 11-1-76
Well depth 45 ft.

7. __ Cable tool X Rotary __ Driven __ Dug
__ Hollow rod __ Jetted __ Bored __ Reverse rotary

8. Use: X Domestic __ Public supply __ Industry
__ Irrigation __ Air conditioning __ Stock
__ Lawn __ Oil field water __ Other

9. Casing: Material styrene Height: Above or below
Threaded __ Welded gl Surface 12 in.
RMP X PVC __ Weight __ lbs./ft.
Dia. 5 in. to 45 ft. depth Wall Thickness: inches or
Dia. __ in. to __ ft. depth gage No. .200

10. Screen: Manufacturer's name Sunflower Plastic
Type styrene Dia. 5"
Slot/gauze 06 Length 10'
Set between 35 ft. and 45 ft.
__ ft. and __ ft.
Gravel pack? yes Size range of material 1/8"

11. Static water level: mo./day/yr.
15 ft. below land surface Date 11-1-76

12. Pumping level below land surfaces:
__ ft. after __ hrs. pumping __ g.p.m.
__ ft. after __ hrs. pumping __ g.p.m.
Estimated maximum yield __ g.p.m.

13. Water sample submitted: mo./day/yr.
__ Yes __ No Date

14. Well head completion: 12 capped
__ Pitless adapter __ Inches above grade

15. Well grouted? yes
With: __ Neat cement __ Bentonite X Concrete
Depth: From 40 ft. to 14 ft.

16. Nearest source of possible contaminotion: City
ft. 50 Direction North Type Sewer
Well disinfected upon completion? X Yes __ No

17. Pump: X Not installed
Manufacturer's name
Model number HP Volts
Length of drop pipe ft. capacity g.p.m.
Type:
__ Submersible __ Turbine
__ Jet __ Reciprocating
__ Centrifugal __ Other

18. Elevation:
Topography:
__ Hill
__ Slope
__ Upland
__ Valley

19. Remarks: Flat Ground

20. Water well contractor's certification:
This well was drilled under my jurisdiction and this report is true to the best of my knowledge and belief.
Harp Well & Pump 236
Business name License No.
Address Wichita, Kansas
Signed M. Arnold Date
Authorized representative 11-3-76

27 T - 1 R W 26 Sec NE 1/4 SE 1/4 NE 1/4

Forward the white, blue and pink copies to the Department of Health and Environment

Form WWC-5

MT-1023