USE TYPEWRITER OR BALL POINT PEN-PRESS FIRMLY, PRINT CLEARLY.

T R EW sec 1/4 1/4 1/4 No.

WATER WELL RECORD
KSA 82a-1201-1215

Kansas State Dept. Of Health
(Water Well Contractors)
Forbes-Bldg. 740
Topeko, Kansas 66620

NW SW NW NE

1 Location of well:	County	Township name	Fraction	Section number	Town number	Range number
	Sedg	Delano	~~SW~~ ~~NE~~ ~~NE~~	27	27	1W

Distance and direction from nearest town or city:

Street address of well location if in city: 415 Maple lane

3 Owner of well: Charlton Izzard

Address: 415 Maple lane Wichita Kansas

Locate with "X" in section below:

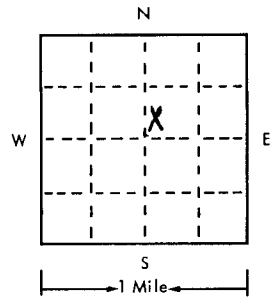

Sketch map:

4 Well depth: 50 ft. Date of completion 7-19
Well diameter 11 in.

5 ☐ Cable tool ☒ Rotary ☐ Driven ☐ Dug
☐ Hollow rod ☐ Jetted ☐ Bored ☐ Reverse rotary

6 Use: ☒ Domestic ☐ Public supply ☐ Industry
☐ Irrigation ☐ Air conditioning ☐ Commercial
☐ Test well ☐ _____

7 Casing: Material Plastic Height: (above) below
Threaded ☐ Welded ☒ Surface 12 in.
Diam. Weight _____ lbs./ft.
11 in. to 10 ft. depth Drive shoe? ☐ Yes ☐ No
5 in. to 50 ft. depth

2 Type and color of material	From	To
Top Soil	0'	3'
Clay	3'	26'
Fine Sand	26'	40'
Large Sand	40'	50'
(use a second sheet if needed)		

8 Screen:
Manufacturer Sunflower
Type Stirrene Dia. 5"
Slot/gauze .1005 Length 10'
Set between 40 ft. and 50 ft.
Fittings:
Gravel pack ☒ Yes ☐ No Size range of material _____

9 Static water level:
15 ft. below land surface Date 7-18-75

10 Pumping level below land surfaces:
15 ft. after 3 hrs. pumping 20 g.p.m.
_____ ft. after _____ hrs. pumping _____ g.p.m.
Estimated maximum yield 200 g.p.m.

11 Water sample submitted:
☐ Yes ☒ No Date _____

12 Well head completion:
☐ Pitless adapter 12 ☒ Inches above grade

13 Well grouted? ☒ Yes ☐ No
☒ Neat cement ☐ Bentonite ☐ _____
Depth: From 0 ft. to 10 ft.

14 Nearest source of possible contamination:
ft. 60' Direction South Type Sewer
Well disinfected upon completion? ☒ Yes ☐ No

15 Pump: ☐ Not installed
Manufacturer's name Dempster
Model number DFA75 HP 3/4 Volts 220
Length of drop pipe 27 ft. capacity 20 g.m.p.
Type:
☒ Submersible ☐ Turbine
☐ Jet ☐ Reciprocating
☐ Certrifugal ☐ Other

16 Remarks: elevation

Topography:
☐ Hill
☐ Slope
☐ Upland
☒ Valley

17 Water well contractor's certification:
This well was drilled under my jurisdiction and this report is true to the best of my knowledge and belief.
21st Electric Inc 129
Business name License No.
Address 512 W 21st
Signed C.S. Harris Date 7-24-75
Authorized representative

Forward the white, blue and pink copies to the Kansas State Dept. Of Health.

Form WWC-5

677-H