

1 LOCATION OF WATER WELL: Fraction SE 1/4 NE 1/4 NW 1/4 Section Number 29 Township Number T 27 S Range Number R 1 E

Distance and direction from nearest town or city street address of well if located within city? See Below 28

2 WATER WELL OWNER:

RR#, St. Address, Box #

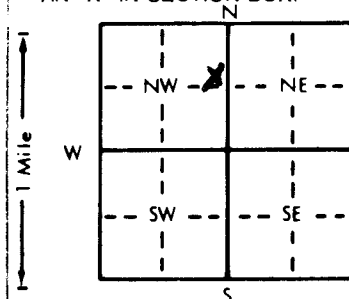
City, State, ZIP Code

MARY BRENNAN
SON F1048
WICHITA KS 67209

Board of Agriculture, Division of Water Resources

Application Number:

3 LOCATE WELL'S LOCATION WITH AN "X" IN SECTION BOX:

4 DEPTH OF COMPLETED WELL: 80 ft. ELEVATION:


WELL'S STATIC WATER LEVEL 29 ft. below land surface measured on 6-19-90

Pump test data: Well water was 29 ft. after 12 hours pumping 20 gpm

Est. Yield 75 gpm: Well water was 29 ft. after 12 hours pumping 20 gpm

Bore Hole Diameter 1 1/8 in. to 80 ft. and 80 in. to 80 ft.

WELL WATER TO BE USED AS: 5 Public water supply 8 Air conditioning 11 Injection well
1 Domestic 3 Feedlot 6 Oil field water supply 9 Dewatering 12 Other (Specify below)
2 Irrigation 4 Industrial 7 Lawn and garden only 10 Monitoring well

Was a chemical/bacteriological sample submitted to Department? Yes X No X; If yes, mo/day/yr sample was submitted

Water Well Disinfected? Yes X No X

5 TYPE OF BLANK CASING USED:

- 1 Steel 3 RMP (SR)
2 PVC 4 ABS

- 5 Wrought iron 8 Concrete tile
6 Asbestos-Cement 9 Other (specify below)
7 Fiberglass

CASING JOINTS: Glued X Clamped X

Welded X

Threaded X


Casing height above land surface 12 in., weight 1.59 lbs./ft. Wall thickness or gauge SDR-26

TYPE OF SCREEN OR PERFORATION MATERIAL:

- 1 Steel 3 Stainless steel 5 Fiberglass
2 Brass 4 Galvanized steel 6 Concrete tile

- 7 PVC 10 Asbestos-cement
8 RMP (SR) 11 Other (specify)
9 ABS 12 None used (open hole)

SCREEN OR PERFORATION OPENINGS ARE:

- 1 Continuous slot 3 Mill slot
2 Louvered shutter 4 Key punched

- 5 Gauzed wrapped 8 Saw cut 11 None (open hole)
6 Wire wrapped 9 Drilled holes
7 Torch cut 10 Other (specify)



6 GROUT MATERIAL:

- 1 Neat cement 2 Cement grout 3 Bentonite 4 Other


What is the nearest source of possible contamination:

- 1 Septic tank 4 Lateral lines 7 Pit privy 10 Livestock pens 14 Abandoned water well
2 Sewer lines 5 Cess pool 8 Sewage lagoon 11 Fuel storage 15 Oil well/Gas well
3 Watertight sewer lines 6 Seepage pit 9 Feedyard 12 Fertilizer storage 16 Other (specify below)
13 Insecticide storage

Direction from well? West

How many feet? 90

FROM	TO	LITHOLOGIC LOG	FROM	TO	PLUGGING INTERVALS
0	2	Top so. 1			
2	23	clay			
23	37	fine sand.			
37	40	clay			
40	61	fine sand.			
61	80	gravel			

7 CONTRACTOR'S OR LANDOWNER'S CERTIFICATION: This water well was (1) constructed, (2) reconstructed, or (3) plugged under my jurisdiction and was completed on (mo/day/year) 6-19-90 and this record is true to the best of my knowledge and belief. Kansas

Water Well Contractor's License No. 318 This Water Well Record was completed on (mo/day/yr) 6-19-90
under the business name of Weninger, Dull by (signature) [Signature]