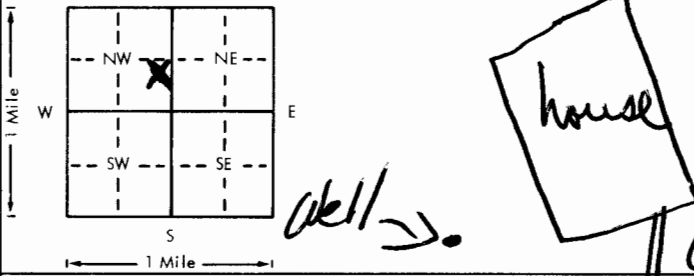


USE TYPEWRITER OR BALL
POINT PEN-PRESS FIRMLY,
PRINT CLEARLY.

WATER WELL RECORD
KSA 82a-1201-1215

Kansas Department of Health and
Environment-Division of Environment
(Water well Contractors)
Topeka, Kansas 66620

1. Location of well: County <u>Sedgewick</u> Fraction <u>NE 1/4 SE 1/4 NW 1/4</u> Section number <u>28</u> Township number <u>T 27 S</u> Range number <u>R 1 E</u>	
2. Distance and direction from nearest town or city: Street address of well location if in city: <u>532 Ingersoll Wichita KS</u>	
3. Owner of well: <u>Helen Suemman</u> R.R. or street: <u>532 Ingersoll</u> City, state, zip code: <u>Wichita KS 67209</u>	
4. Locate with "X" in section below: Sketch map: 	
5. Type and color of material	
6. Bore hole dia. <u>8 1/2</u> in. Completion date <u>5/8/79</u> Well depth <u>80</u> ft.	
7. ☐ Cable tool ☒ Rotary ☐ Driven ☐ Dug ☐ Hollow rod ☐ Jetted ☐ Bored ☐ Reverse rotary	
8. Use: ☒ Domestic ☐ Public supply ☐ Industry ☐ Irrigation ☐ Air conditioning ☐ Stock ☐ Law ☐ Oil field water ☐ Other	
9. Casing: Material <u>Steel</u> Weight <u>12</u> lbs./ft. Threaded ☒ Welded ☒ Surface ☐ RMP ☒ PVC ☐ Weight <u>1.50</u> lbs./ft. Dia. <u>8 1/2</u> in. depth <u>80</u> ft. Wall thickness: inches or Dia. <u>8 1/2</u> in. to <u>8 1/2</u> ft. depth gage No. <u>200</u>	
10. Screen: Manufacturer's name <u>Sunflower</u> Type <u>200</u> Dia. <u>5 1/2</u> Slot gauge <u>1/16</u> Length <u>2 1/2</u> Set between <u>11/16</u> ft. and <u>7/8</u> ft. Gravel pack? <u>yes</u> Size range of material <u>3/8</u>	
11. Static water level: <u>27</u> ft. below land surface Date <u>5/8/79</u>	
12. Pumping level below land surfaces: <u>30</u> ft. after <u>1/2</u> hrs. pumping <u>15</u> g.p.m. <u>30</u> ft. after <u>1</u> hrs. pumping <u>15</u> g.p.m. Estimated maximum yield <u>40</u> g.p.m.	
13. Water sample submitted: <u>Yes</u> ☒ No ☐ Date <u>5/8/79</u>	
14. Well head completion: ☒ Pitless adapter <u>12</u> inches above grade	
15. Well grouted? <u>yes</u> With: ☐ Neat cement ☐ Bentonite ☒ Concrete Depth: From <u>3</u> ft. to <u>13</u> ft.	
16. Nearest source of possible contamination: <u>City Main</u> ft. <u>30</u> Direction <u>So</u> Type <u>Main</u> Well disinfected upon completion? ☒ Yes ☐ No	
17. Pump: Manufacturer's name <u>X</u> Not installed Model number <u>HP</u> Volts <u>115</u> Length of drop pipe <u>1</u> ft. capacity <u>1</u> g.p.m. Type: ☐ Submersible ☐ Turbine ☐ Jet ☐ Reciprocating ☐ Centrifugal ☐ Other	
18. Elevation: <u>Topsoil</u> <u>Red clay</u> <u>fine sand</u> <u>gray clay</u> <u>fine sand</u> <u>gray clay</u> <u>fine to med sand</u> <u>gray clay</u> <u>med sand</u> <u>gray clay</u>	
19. Remarks: <u>Customer to furnish 4'x4'x4'</u> <u>slab around well at grade</u> <u>for State Regulations</u> <u>Signed X Mrs. A. Suemman</u>	
20. Water well contractor's certification: This well was drilled under my jurisdiction and this report is true to the best of my knowledge and belief. Business name <u>Alvin J. Bull</u> License No. <u>38</u> Address <u>Wichita KS</u> Signed <u>Alvin J. Bull</u> Date <u>5/8/79</u> Authorized representative	

Forward the white, blue and pink copies to the Department of Health and Environment

Form WWG-5