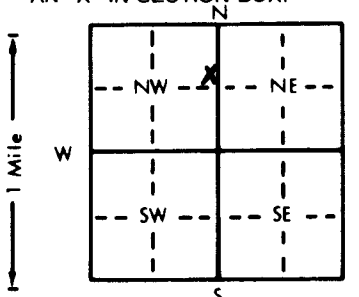


1 LOCATION OF WATER WELL:		Fraction		Section Number		Township Number		Range Number			
County: Sedgwick		SE 1/4 NE 1/4 NW 1/4		28		T 27 S		R 1W E/W			
Distance and direction from nearest town or city street address of well if located within city?											
555 So. Woodchuck Wichita, Kansas											
2 WATER WELL OWNER: Reddi, Martha											
RR#, St. Address, Box #: 555 Woodchuck Board of Agriculture, Division of Water Resources											
City, State, ZIP Code: Wichita, Kansas Application Number:											
3 LOCATE WELL'S LOCATION WITH AN "X" IN SECTION BOX:		4 DEPTH OF COMPLETED WELL: 80 ft. ELEVATION:									
		Depth(s) Groundwater Encountered 1. ft. 2. ft. 3. ft.									
		WELL'S STATIC WATER LEVEL 30 ft. below land surface measured on mo/day/yr 8-26-91									
		Pump test data: Well water was ft. after hours pumping gpm									
		Est. Yield gpm: Well water was ft. after hours pumping gpm									
		Bore Hole Diameter 11 in. to 80 ft., and in. to ft.									
		WELL WATER TO BE USED AS: 5 Public water supply 8 Air conditioning 11 Injection well									
		1 Domestic 3 Feedlot 6 Oil field water supply 9 Dewatering 12 Other (Specify below)									
		2 Irrigation 4 Industrial 7 Lawn and garden only 10 Monitoring well									
		Was a chemical/bacteriological sample submitted to Department? Yes No X; If yes, mo/day/yr sample was submitted									
		Water Well Disinfected? Yes X No									
5 TYPE OF BLANK CASING USED:											
1 Steel 3 RMP (SR) 5 Wrought iron 8 Concrete tile CASING JOINTS: Glued X Clamped											
2 PVC 4 ABS 6 Asbestos-Cement 9 Other (specify below) Welded											
7 Fiberglass SDR-26 Threaded											
Blank casing diameter 5 in. to 60 ft., Dia in. to ft., Dia in. to ft.											
Casing height above land surface 12 in., weight 2.29 lbs./ft. Wall thickness or gauge No. 214											
TYPE OF SCREEN OR PERFORATION MATERIAL:											
1 Steel 3 Stainless steel 5 Fiberglass 7 PVC 10 Asbestos-cement											
2 Brass 4 Galvanized steel 6 Concrete tile 8 RMP (SR) 11 Other (specify)											
12 None used (open hole)											
SCREEN OR PERFORATION OPENINGS ARE:											
1 Continuous slot 3 Mill slot 5 Gauzed wrapped 8 Saw cut 11 None (open hole)											
2 Louvered shutter 4 Key punched 6 Wire wrapped 9 Drilled holes											
7 Torch cut 10 Other (specify)											
SCREEN-PERFORATED INTERVALS: From 60 ft. to 80 ft., From ft. to ft.											
From ft. to ft., From ft. to ft.											
GRAVEL PACK INTERVALS: From 24 ft. to 80 ft., From ft. to ft.											
From ft. to ft., From ft. to ft.											
6 GROUT MATERIAL: 1 Neat cement 2 Cement grout 3 Bentonite 4 Other											
Grout Intervals: From 4 ft. to 24 ft., From ft. to ft., From ft. to ft.											
What is the nearest source of possible contamination:											
1 Septic tank 4 Lateral lines 7 Pit privy 10 Livestock pens 14 Abandoned water well											
2 Sewer lines 5 Cess pool 8 Sewage lagoon 11 Fuel storage 15 Oil well/Gas well											
3 Watertight sewer lines 6 Seepage pit 9 Feedyard 12 Fertilizer storage 16 Other (specify below)											
13 Insecticide storage											
Direction from well? West How many feet? 90											
FROM		TO		LITHOLOGIC LOG		FROM		TO		PLUGGING INTERVALS	
0		3		topsoil							
3		18		clay							
18		31		fine sand							
31		50		medium sand							
50		52		clay							
52		80		fine sand							
7 CONTRACTOR'S OR LANDOWNER'S CERTIFICATION: This water well was (1) constructed, (2) reconstructed, or (3) plugged under my jurisdiction and was completed on (mo/day/year) 8-26-91 and this record is true to the best of my knowledge and belief. Kansas											
Water Well Contractor's License No. 236 This Water Well Record was completed on (mo/day/yr) 12-2-91											
under the business name of Harp Well and Pump Service, Inc. by (signature) Mary Arnold											
INSTRUCTIONS: Use typewriter or ball point pen. PLEASE PRESS FIRMLY and PRINT clearly. Please fill in blanks, underline or circle the correct answers. Send three copies to Kansas Department of Health and Environment, Bureau of Water, Topeka, Kansas 66620-0001. Telephone: 913-296-5545. Send one to WATER WELL OWNER and retain one for your records.											