


1 LOCATION OF WATER WELL:		Fraction		Section Number		Township Number		Range Number	
County: SEDGWICK		NW 1/4 NW 1/4 SW 1/4		28		T 27 S		R 1 W E/W	
Distance and direction from nearest town or city street address of well if located within city?					Security Oil Company #2				
NE corner of Tyler Road and West Hiway 54					Wichita, KS.				
2 WATER WELL OWNER:		Phillips 66							
RR#, St. Address, Box # :		1254 South Tyler Road							
City, State, ZIP Code :		Wichita, KS. 67209							
3 LOCATE WELL'S LOCATION WITH AN "X" IN SECTION BOX:		4 DEPTH OF COMPLETED WELL: 45 ft. ELEVATION:							
		Depth(s) Groundwater Encountered 1. ft. 2. ft. 3. ft.							
		WELL'S STATIC WATER LEVEL 32.35 . . ft. below land surface measured on mo/day/yr 2-21-92							
		Pump test data: Well water was ft. after hours pumping gpm							
		Est. Yield gpm: Well water was ft. after hours pumping gpm							
		Bore Hole Diameter 8 . . . in. to 45 . . . ft. and in. to ft.							
		WELL WATER TO BE USED AS: 5 Public water supply 8 Air conditioning 11 Injection well							
		1 Domestic 3 Feedlot 6 Oil field water supply 9 Dewatering 12 Other (Specify below)							
		2 Irrigation 4 Industrial 7 Lawn and garden only 10 Monitoring well							
		Was a chemical/bacteriological sample submitted to Department? Yes No XX If yes, mo/day/yr sample was submitted							
		Water Well Disinfected? Yes No XX							
5 TYPE OF BLANK CASING USED:		5 Wrought iron 8 Concrete tile CASING JOINTS: Glued Clamped							
1 Steel 3 RMP (SR)		6 Asbestos-Cement 9 Other (specify below) Welded							
2 PVC sch 40 4 ABS		7 Fiberglass Threaded Flush Joint							
Blank casing diameter 2 in. to 25 ft. Dia in. to ft. Dia in. to ft.									
Casing height above land surface Flush Mount in. weight 703 lbs./ft. Wall thickness or gauge No. 154									
TYPE OF SCREEN OR PERFORATION MATERIAL:		7 PVC 10 Asbestos-cement							
1 Steel 3 Stainless steel 5 Fiberglass		8 RMP (SR) 11 Other (specify)							
2 Brass 4 Galvanized steel 6 Concrete tile		9 ABS 12 None used (open hole)							
SCREEN OR PERFORATION OPENINGS ARE:		5 Gauzed wrapped 8 Saw cut 11 None (open hole)							
1 Continuous slot 3 Mill slot 6 Wire wrapped 9 Drilled holes									
2 Louvered shutter 4 Key punched 7 Torch cut 10 Other (specify)									
SCREEN-PERFORATED INTERVALS: From 25 ft. to 45 ft. From ft. to ft.									
GRAVEL PACK INTERVALS: From 22.9 ft. to 45 ft. From ft. to ft.									
6 GROUT MATERIAL: 1 Neat cement 2 Cement grout 3 Bentonite 4 Other		HOLE 22.9 ft. From ft. to ft.							
Grout Intervals: From 0 ft. to 1 ft. From ft. to ft.									
What is the nearest source of possible contamination:		10 Livestock pens 14 Abandoned water well							
1 Septic tank 4 Lateral lines 7 Pit privy 11 Fuel storage 15 Oil well/Gas well									
2 Sewer lines 5 Cess pool 8 Sewage lagoon 12 Fertilizer storage 16 Other (specify below)									
3 Watertight sewer lines 6 Seepage pit 9 Feedyard 13 Insecticide storage NA									
Direction from well?		How many feet?							
FROM TO LITHOLOGIC LOG FROM TO PLUGGING INTERVALS									
0 3 Topsoil									
3 15 Clay									
15 35 Fine silty sand									
35 45 Medium to coarse sand									
7 CONTRACTOR'S OR LANDOWNER'S CERTIFICATION: This water well was (1) constructed, (2) reconstructed, or (3) plugged under my jurisdiction and was completed on (mo/day/year) 2-21-92 and this record is true to the best of my knowledge and belief. Kansas Water Well Contractor's License No. 236 This Water Well Record was completed on (mo/day/yr) 3-30-92 under the business name of Harp Well & Pump Service, Inc. by (signature) Mary Arnold									
INSTRUCTIONS: Use typewriter or ball point pen. PLEASE PRESS FIRMLY and PRINT clearly. Please fill in blanks, underline or circle the correct answers. Send up three copies to Kansas Department of Health and Environment, Bureau of Water, Topeka, Kansas 66620-0001. Telephone: 913-296-5545. Send one to WATER WELL OWNER and retain one for your records.									

PHONE
(316) 722-1411

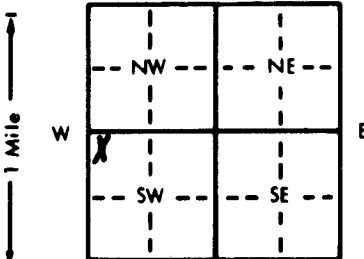

HARP WELL & PUMP SERVICE, INC.

Water Well Drilling - Piling Hole Drilling - Test Drilling
Gravel Packed Wells for
Home - Industrial - Municipal - Irrigation
PUMP SALES & SERVICE

215 SO. TYLER ROAD

WICHITA, KANSAS 67209

Date 2-21-92

Schrader Bros. Constr. Co.
JOB/ Security Oil Company, Tyler Road & Kellogg
MW-2

Depth - Log
0

Description

	Height of Protective Housing above Ground Surface: <u>Flush mounted</u>
	Elevation of Top of Primary Casing: _____
	Length of Protective Housing: _____
	Type of Protective Cap: <u>Flushed mounted</u>
	Ground Surface Elevation: _____
	Depth to Bottom of Surface Casing if Used: <u>N/A</u>
	Type of Surface Seal: <u>Cement</u>
	Inside Diameter of Primary Casing: <u>2"</u>
	Primary Casing Material: <u>PVC Schedule 40</u>
	Diameter of Borehole: <u>6"</u>
	Type of Backfill: <u>Bentonite hole plug</u>
	Depth to Top of Seal: <u>20.9'</u>
	Type of Seal: <u>Bentonite</u>
	Depth to Top of Gravel Pack: <u>22.9'</u>
	Type of Packing: <u>Silica Sand #8 and natural sand</u>

RECEIVED
MAY 16 1992
DIVISION OF ENVIRONMENT

	Depth to Top of Screen: <u>25'</u>
	I.D. of Well Screen: <u>2"</u>
	Type of Well Screen: <u>PVC 10 slot Schedule 40</u>
	Depth to Bottom of Screen: <u>45'</u>
	Type of Bottom Cap: <u>PVC pointed end cap</u>
	Depth to Bottom of Borehole: <u>45'</u>