USE TYPEWRITER OR BALL POINT PEN-PRESS FIRMLY, PRINT CLEARLY.

WATER WELL RECORD
KSA 82a-1201-1215

Kansas Department of Health and Environment-Division of Environment
(Water well Contractors)
Topeka, Kansas 66620

1. Location of well:	County	Fraction	Section number	Township number	Range number
	Sedgwick	SW 1/4 SW 1/4 SE 1/4	29	T 27 S	R 1 ~~W~~

2. Distance and direction from nearest town or city:

Street address of well location if in city: 9520 W. Harry

3. Owner of well:
R.R. or street:
City, state, zip code: Walt Keeler Concrete Wichita, Kansas

4. Locate with "X" in section below: Sketch map:

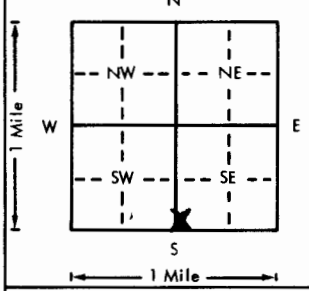

Well No. 1 (1-76)

6. Bore hole dia. 24 in. Completion date
Well depth 100 ft. 6/4/76

7. __ Cable tool X Rotary __ Driven __ Dug
__ Hollow rod __ Jetted __ Bored __ Reverse rotary

8. Use: __ Domestic __ Public supply X Industry
__ Irrigation __ Air conditioning __ Stock
__ Lawn __ Oil field water __ Other

9. Casing: Material PL Height: Above ~~or below~~
Threaded __ Welded __ Surface 12 in.
RMP __ PVC X Weight __ lbs./ft.
Dia. 8 in. to 60 ft. depth Wall Thickness: inches or
Dia. __ in. to __ ft. depth gage No. Class 160

5. Type and color of material	From	To
Sand & rock fill	0	3
Brown & gray clay - tight	3	30
Brown clay w/sand streaks	30	41
Fine to coarse sand to med. gravel	41	60
Med. to coarse sand & gravel	60	100

(Use a second sheet if needed)

10. Screen: Manufacturer's name
Type Plastic Dia. 8"
Slot/gauze Length 40'
Set between 60 ft. and 100 ft.
ft. and ft.
Gravel pack? Yes Size range of material 1/8 x 3/8

11. Static water level: mo./day/yr.
24 ft. below land surface Date 6/4/76

12. Pumping level below land surfaces:
ft. after hrs. pumping g.p.m.
ft. after hrs. pumping g.p.m.
Estimated maximum yield g.p.m.

13. Water sample submitted: mo./day/yr.
__ Yes X No Date

14. Well head completion:
__ Pitless adapter 12 Inches above grade

15. Well grouted? yes
With: __ Neat cement __ Bentonite X Concrete
Depth: From 0 ft. to 15 ft.

16. Nearest source of possible contamination:
ft. 100 Direction South Type Septic field
Well disinfected upon completion? X Yes __ No

17. Pump: X Not installed
Manufacturer's name
Model number HP Volts
Length of drop pipe ft. capacity g.p.m.
Type:
__ Submersible __ Turbine
__ Jet __ Reciprocating
__ Centrifugal __ Other

18. Elevation:
Topography:
__ Hill
__ Slope
X Upland
__ Valley

19. Remarks:

20. Water well contractor's certification:
This well was drilled under my jurisdiction and this report is true to the best of my knowledge and belief.
Layne Western Co. 102
Business name License No.
Address 1011 W. Harry Wichita
Signed Authorized representative Date 6-7-76

Forward the white, blue and pink copies to the Department of Health and Environment

Form WWC-5

MT-1023

27 T — 1 R W
29 Sec
SW 1/4 SW 1/4 SE 1/4