

1 LOCATION OF WATER WELL: Fraction NE 1/4 SE 1/4 NE 1/4 Section Number 29 Township Number T 27 S Range Number R 1 E  
 County: Seola  
 Distance and direction from nearest town or city street address of well if located within city?

2 WATER WELL OWNER:

RR#, St. Address, Box #:

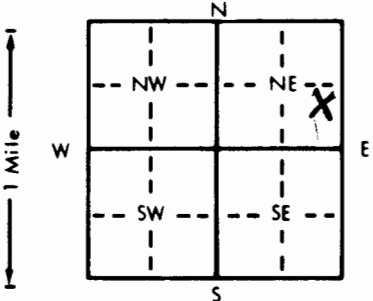
City, State, ZIP Code:

Same as below  
Bob Schwarzenberger  
510 Tippacanoe Wichita KS 67212

Board of Agriculture, Division of Water Resources

Application Number:

3 LOCATE WELL'S LOCATION WITH AN "X" IN SECTION BOX:

4 DEPTH OF COMPLETED WELL: 50 ft. ELEVATION:Depth(s) Groundwater Encountered 1. 22 ft. 2. 22 ft. 3. 7-12-84 ft.WELL'S STATIC WATER LEVEL 22 ft. below land surface measured on mo/day/yr 7-12-84Pump test data: Well water was 22 ft. after 1/2 hours pumping 20 gpmEst. Yield 40 gpm: Well water was 22 ft. after 1/2 hours pumping 20 gpmBore Hole Diameter 1 1/2 in. to 50 ft., and 50 in. to 50 ft.WELL WATER TO BE USED AS: 5 Public water supply 8 Air conditioning 11 Injection well

1 Domestic 3 Feedlot 6 Oil field water supply 9 Dewatering 12 Other (Specify below)

2 Irrigation 4 Industrial 7 Lawn and garden only 10 Observation well

Was a chemical/bacteriological sample submitted to Department? Yes X No X If yes, mo/day/yr sample was submittedWater Well Disinfected? Yes X No X

5 TYPE OF BLANK CASING USED:

1 Steel 8 RMP (SR)2 PVC 4 ABS

5 Wrought iron

6 Asbestos-Cement

7 Fiberglass

8 Concrete tile

9 Other (specify below)

CASING JOINTS: Glued X Clamped

Welded

Threaded

Blank casing diameter 5 in. to 30 ft., Dia. 5 in. to 30 ft., Dia. 5 in. to 30 ft.Casing height above land surface 12 in., weight 1.59 lbs./ft. Wall thickness or gauge No 50-26

TYPE OF SCREEN OR PERFORATION MATERIAL:

1 Steel 3 Stainless steel

2 Brass 4 Galvanized steel

5 Fiberglass

6 Concrete tile

7 PVC

8 RMP (SR)

9 ABS

10 Asbestos-cement

11 Other (specify)

12 None used (open hole)

SCREEN OR PERFORATION OPENINGS ARE:

1 Continuous slot 3 Mill slot

2 Louvered shutter 4 Key punched

5 Gauzed wrapped

6 Wire wrapped

7 Torch cut

8 Saw cut

9 Drilled holes

10 Other (specify)

11 None (open hole)

SCREEN-PERFORATED INTERVALS: From 30 ft. to 50 ft., From 30 ft. to 50 ft., From 30 ft. to 50 ft.GRAVEL PACK INTERVALS: From 13 ft. to 50 ft., From 13 ft. to 50 ft., From 13 ft. to 50 ft.

6 GROUT MATERIAL:

1 Neat cement

2 Cement grout

3 Bentonite

4 Other

Grout Intervals: From 3 ft. to 13 ft., From 3 ft. to 13 ft., From 3 ft. to 13 ft.

What is the nearest source of possible contamination:

1 Septic tank 4 Lateral lines

2 Sewer lines 5 Cess pool

3 Watertight sewer lines 6 Seepage pit

7 Pit privy

8 Sewage lagoon

9 Feedyard

10 Livestock pens

11 Fuel storage

12 Fertilizer storage

13 Insecticide storage

14 Abandoned water well

15 Oil well/Gas well

16 Other (specify below)

Direction from well?

How many feet? 65

| FROM | TO | LITHOLOGIC LOG | FROM | TO | LITHOLOGIC LOG |
|------|----|----------------|------|----|----------------|
| 0    | 2  | Top 50' 1.     |      |    |                |
| 2    | 21 | Clay           |      |    |                |
| 21   | 42 | Sand           |      |    |                |
| 42   | 43 | Clay           |      |    |                |
| 43   | 50 | Sand           |      |    |                |

7 CONTRACTOR'S OR LANDOWNER'S CERTIFICATION: This water well was (1) constructed (2) reconstructed, or (3) plugged under my jurisdiction and was

completed on (mo/day/year) 9-12-84 and this record is true to the best of my knowledge and belief. KansasWater Well Contractor's License No. 318 This Water Well Record was completed on (mo/day/yr) 9-13-84under the business name of Weninger Drilling by (signature) [Signature]

INSTRUCTIONS: Use typewriter or ball point pen. PLEASE PRESS FIRMLY and PRINT clearly. Please fill in blanks, underline or circle the correct answers. Send top

three copies to Kansas Department of Health and Environment, Division of Environment, Environmental Geology Section, Topeka, KS 66620. Send one to WATER WELL

OWNER and retain one for your records.