USE TYPEWRITER OR BALL POINT PEN-PRESS FIRMLY, PRINT CLEARLY.

WATER WELL RECORD
KSA 82a-1201-1215

Kansas Department of Health and Environment-Division of Environment
(Water well Contractors)
Topeka, Kansas 66620

1. Location of well:	County	Fraction	Section number	Township number	Range number
	SEDGWICK	SE 1/4 SE 1/4 SE 1/4	29	T 27 S	R 1W E/W

2. Distance and direction from nearest town or city: ¼ W. of Tyler Rd., on Harry, on the N. side of the rd.
Street address of well location if in city:

3. Owner of well: H.T. Patterson
R.R. or street: 9208 W. Harry
City, state, zip code: Wichita, Kansas

4. Locate with "X" in section below:

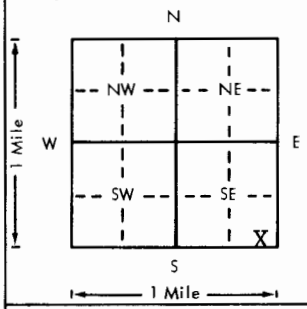

Sketch map: Wichita, Kansas

6. Bore hole dia. 11 in. Completion date
Well depth 100 ft. 7-21-78

7. __ Cable tool X Rotary __ Driven __ Dug
__ Hollow rod __ Jetted __ Bored __ Reverse rotary

8. Use: X Domestic __ Public supply __ Industry
__ Irrigation __ Air conditioning __ Stock
__ Lawn __ Oil field water __ Other

9. Casing: Material Styrene
Threaded ___ Welded gl
RMP X PVC ___
Dia. 5 in. to 100 ft. depth
Dia. ___ in. to ___ ft. depth
Height: Above or below
Surface 12 in.
Weight ___ lbs./ft.
Wall Thickness: inches or gage No. .200

5. Type and color of material	From	To
Topsoil	0	3
Clay	3	25
Fine Sand	25	38
Medium Sand	38	45
Fine Sand	45	60
Clay	60	75
Fine Sand	75	86
Medium Sand	86	100

(Use a second sheet if needed)

10. Screen: Manufacturer's name Sunflower Plastic
Type styrene Dia. 5"
Slot/gauze .06 Length 10'
Set between 90 ft. and 100 ft.
___ ft. and ___ ft.
Gravel pack? yes Size range of material ¼-1/8"

11. Static water level: mo./day/yr.
20 ft. below land surface Date 7-21-78

12. Pumping level below land surfaces:
___ ft. after ___ hrs. pumping ___ g.p.m.
___ ft. after ___ hrs. pumping ___ g.p.m.
Estimated maximum yield ___ g.p.m.

13. Water sample submitted: mo./day/yr.
__ Yes __ No Date

14. Well head completion: capped
__ Pitless adapter 12 Inches above grade

15. Well grouted? yes 1-2Fine Sand Mix
With: __ Neat cement __ Bentonite X Concrete
Depth: From 40" ft. to 14 ft.

16. Nearest source of possible contamination: Septic
ft. 100 Direction S.E. Type Tank
Well disinfected upon completion? X Yes __ No

17. Pump: X Not installed
Manufacturer's name
Model number ___ HP ___ Volts ___
Length of drop pipe ___ ft. capacity ___ g.p.m.
Type:
__ Submersible __ Turbine
__ Jet __ Reciprocating
__ Centrifugal __ Other

18. Elevation:
Topography:
__ Hill
__ Slope
__ Upland
__ Valley

19. Remarks: Flat Ground

20. Water well contractor's certification:
This well was drilled under my jurisdiction and this report is true to the best of my knowledge and belief.
Harp Well & Pump 236
Business name License No.
Address Wichita, Kansas 67209
Signed M. Arnold Date 8-7-78
Authorized representative

T 27 R 1 E/W Sec 29 1/4 1/4 1/4 1/4

Forward the white, blue and pink copies to the Department of Health and Environment

Form WWC-5

MI-1023