USE TYPEWRITER OR BALL POINT PEN-PRESS FIRMLY, PRINT CLEARLY.

WATER WELL RECORD
KSA 82a-1201-1215

Kansas Department of Health and Environment-Division of Environment
(Water well Contractors)
Topeka, Kansas 66620

1. Location of well:	County	Fraction	Section number	Township number	Range number
	SEDGWICK	1/4 SE 1/4 NW 1/4	30	T 27 S	R 1 E (W)

2. Distance and direction from nearest town or city: 11308 VALLEY HIGH
Street address of well location if in city: WICHITA, KANSAS

3. Owner of well: D. PALMER
R.R. or street: 11308 VALLEY HIGH
City, stote, zip code: WICHITA, KANSAS

4. Locote with "X" in section below:

Sketch map:

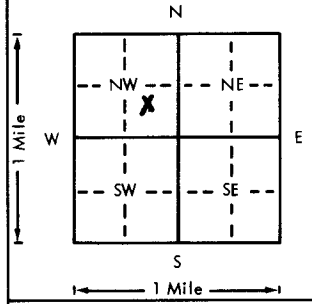

5. Type and color of material	From	To
SANDY BROWN SOIL	0	3
SANDY SOIL WITH CLAY STREAKS	3	15
DIRTY BROWN SAND	15	25
FINE SAND	25	35
MEDIUM COARSE SAND	35	60
GREY CLAY	60	85
FINE SAND	85	105
COARSE SAND	105	125
(Use a second sheet if needed)		

6. Bore hole dia. 11 in. Completion date 9-8-76
Well depth 125 ft.

7. __ Cable tool ✓ Rotary __ Driven __ Dug
__ Hollow rod __ Jetted __ Bored __ Reverse rotary

8. Use: __ Domestic __ Public supply __ Industry
__ Irrigation __ Air conditioning __ Stock
✓ Lawn __ Oil field water __ Other

9. Casing: Material STYRENE Weight: (Above) or below
Threaded __ Welded __ Surface 13 in.
RMP ✓ PVC __ Weight __ lbs./ft.
Dia. 5 in. to 125 ft. depth Wall Thickness: inches or
Dia. __ in. to __ ft. depth gage No. 200

10. Screen: Manufacturer's name SUNFLOWER PLASTIC
Type STYRENE Dia. 5"
Slot/gauze 106 Length 30
Set between 105 ft. and 125 ft.
__ ft. and __ ft.
Gravel pack? YES Size range of material 1/4 - 1/8"

11. Static water level: mo./day/yr.
35 ft. below land surface Date 9-8-76

12. Pumping level below land surfaces:
__ ft. after __ hrs. pumping __ g.p.m.
__ ft. after __ hrs. pumping __ g.p.m.
Estimoted maximum yield __ g.p.m.

13. Water sample submitted: mo./day/yr.
__ Yes __ No Date __

14. Well head completion: CAPPED
__ Pitless adapter 12 Inches above grade

15. Well grouted? YES
With: __ Neat cement __ Bentonite ✓ Concrete
Depth: From 40" ft. to 14 ft.

16. Nearest source of possible contamination: SEPTIC
ft. 65 Direction NE Type TANK
Well disinfected upon completion? ✓ Yes __ No

17. Pump: ✓ Not installed
Manufacturer's name __
Model number __ HP __ Volts __
Length of drop pipe __ ft. capacity __ g.p.m.
Type:
__ Submersible __ Turbine
__ Jet __ Reciprocating
__ Centrifugal __ Other

18. Elevation:
Topography:
__ Hill
__ Slope
__ Upland
__ Valley

19. Remarks:
FLAT GROUND

20. Water well contractor's certification:
This well was drilled under my jurisdiction and this report is true to the best of my knowledge and belief.
Business name HARP WELL + PUMP License No. 236
Address WICHITA, KANSAS
Signed M. Arnold Authorized representative Date 10-20-76

27 T — 1 R E (W) 30 Sec SE 1/4 NW 1/4

Forward the white, blue and pink copies to the Department of Health and Environment

Form WWC-5

MI-1023