USE TYPEWRITER OR BALL POINT PEN-PRESS FIRMLY, PRINT CLEARLY.

T R EW sec 1/4 1/4 1/4 No.

WATER WELL RECORD
KSA 82a-1201-1215

Kansas State Dept. Of Health
(Water Well Contractors)
Forbes-Bldg. 740
Topeka, Kansas 66620

1 Location of well:	County	Township name	Fraction	Section number	Town number	Range number
	Sedgwick	Delano	NENENW	30	27S	1W

Distance and direction from nearest town or city: 350 Covington
Street address of well location if in city: Wichita, Kansas

3 Owner of well: H. W. Keys Building Company
Address: 301 Shefford Wichita, Kansas 67209

Locate with "X" in section below:

Sketch map:

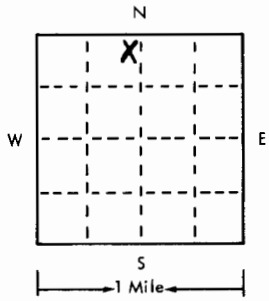

4 Well depth: 150 ft. Date of completion 4-25-75
Well diameter 11 in.

5 ☐ Cable tool ☒ Rotary ☐ Driven ☐ Dug
☐ Hollow rod ☐ Jetted ☐ Bored ☐ Reverse rotary

6 Use: ☒ Domestic ☐ Public supply ☐ Industry
☐ Irrigation ☐ Air conditioning ☐ Commercial
☐ Test well ☐ _____

7 Casing: Material Styrene Height: above/below ////
Threaded ☐ Welded ☐ Surface 12 in.
Diam. 5 in. to 150 ft. depth Weight ____ lbs./ft.
____ in. to ____ ft. depth Drive shoe? ☐ Yes ☐ No

2

Type and color of material	From	To
Dirt Sandy Clay	0	20
Sand	20	60
Black Clay	60	100
Fine sand and Clay	100	130
Medium Sand	130	150
(use a second sheet if needed)		

8 Screen:
Manufacturer Sunflower Plastic
Type Styrene Dia. 5"
Slot/gauze .005 Length 10'
Set between 140 ft. and 150 ft.
Fittings:
Gravel pack ☐ Yes ☐ No Size range of material ____

9 Static water level:
25 ft. below land surface Date ____

10 Pumping level below land surfaces:
____ ft. after ____ hrs. pumping ____ g.p.m.
____ ft. after ____ hrs. pumping ____ g.p.m.
Estimated maximum yield ____ g.p.m.

11 Water sample submitted:
☐ Yes ☐ No Date ____

12 Well head completion:
☐ Pitless adapter 12 ☒ Inches above grade

13 Well grouted? ☒ Yes ☐ No
☒ Neat cement ☐ Bentonite ☐ _____
Depth: From 0 ft. to 12 ft.

14 Nearest source of possible contamination: NONE
ft. ____ Direction ____ Type ____
Well disinfected upon completion? ☒ Yes ☐ No

15 Pump: ☐ Not installed
Manufacturer's nam[redacted]
Model numb[redacted] HP [redacted] Volt[redacted]
Length of drop pip[redacted]t. capacit[redacted]g.m.p.
Type:
[redacted] Submersible ☐ Turbine
☐ Jet ☐ Reciprocating
☐ Certrifugal ☐ Other

16 Remarks: elevation

Flat Ground
No apparent source for contamination except for sanitary sewer 50' East.
Pump Not Installed at this time.

Topography:
☐ Hill
☐ Slope
☐ Uplond
☐ Valley

17 Water well contractor's certification:
This well was drilled under my jurisdiction and this report is true to the best of my knowledge and belief.
Harp Well & Pump Serv. 236
Business name License No.
Address Wichita, Kansas 67209
Signed Mary Arnold Date 5-3-75
Authorized representative

Forward the white, blue and pink copies to the Kansas State Dept. Of Health.

Form WWC-5

677-H