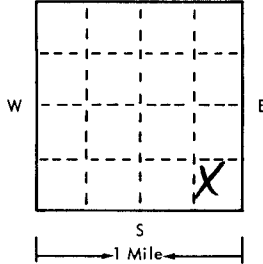
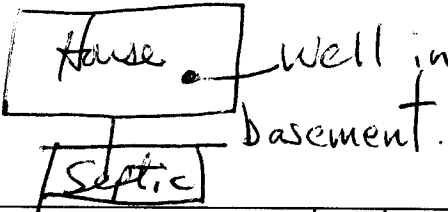


USE TYPEWRITER OR BALL
POINT PEN-PRESS FIRMLY,
PRINT CLEARLY.

WATER WELL RECORD
KSA 82a-1201-1215

T R EW sec 1/4 1/4 1/4 No.

Kansas State Dept. Of Health
(Water Well Contractors)
Forbes-Bldg. 740
Topeka, Kansas 66620

1 Location of well:	County <u>Sedg</u>	Township name <u>Delano</u>	Fraction <u>NWSE</u>	Section number <u>30</u>	Town number <u>275</u>	Range number <u>1W</u>
Distance and direction from nearest town or city: <u>2 m. S. West Wichita Airport</u>		3 Owner of well: <u>MARVIN Niedens</u>				
Street address of well location if in city: <u>10503 Skinner Wichita</u>		Address: <u>1320 Reece Rd Goddard KS</u>				
Locate with "X" in section below: 		Sketch map: 		4 Well depth: <u>65</u> ft. Date of completion <u>11/18</u> Well diameter <u>5</u> in.		
2 Type and color of material		From		To		5 ☐ Cable tool ☒ Rotary ☐ Driven ☐ Dug ☐ Hollow rod ☐ Jetted ☐ Bored ☐ Reverse rotary
						6 Use: ☒ Domestic ☐ Public supply ☐ Industry ☐ Irrigation ☐ Air conditioning ☐ Commercial ☐ Test well
						7 Casing: Material <u>AMP</u> Height: above/below Threaded ☐ Welded ☒ Surface <u>12</u> in. Diam. <u>5</u> in. to <u>65</u> ft. depth Drive shoe? ☐ Yes ☒ No
						8 Screen: <u>Sanflow</u> Manufacturer <u>PLASTIC</u> Dia. <u>5"</u> Slot/gouze <u>1/16</u> Length <u>5'</u> Set between <u>60</u> ft. and <u>65</u> ft. Fittings: Gravel pack ☒ Yes ☐ No Size range of material <u>3/8</u>
Top Soil.		08		9 Static water level: <u>30</u> ft. below land surface Date <u>11/18/5</u>		
Clay.		8 22		10 Pumping level below land surfaces: <u>33</u> ft. after <u>1</u> hrs. pumping <u>18</u> g.p.m. <u>47</u> ft. after <u>47</u> hrs. pumping <u>18</u> g.p.m. Estimated maximum yield <u>80</u> g.p.m.		
Clay mixed with fine sand		22 30		11 Water sample submitted: ☐ Yes ☒ No Date _____		
fine sand		30 47		12 Well head completion: ☐ Pitless adapter <u>12</u> inches above grade		
Gravel		47 65		13 Well grouted? ☒ Yes ☐ No ☒ Neat cement ☐ Bentonite ☐ Depth: From <u>0</u> ft. to <u>10</u> ft. <u>to grade</u>		
				14 Nearest source of possible contamination: ft. <u>75</u> Direction <u>30</u> Type <u>Septic</u> Well disinfected upon completion? ☒ Yes ☐ No		
				15 Pump: <u>Valley</u> Not installed Manufacturer's name <u>Valley</u> Model number <u>180</u> HP <u>1/2</u> Volts <u>230</u> Length of drop pipe <u>50</u> ft. capacity <u>18</u> g.p.m. Type: ☒ Submersible ☐ Turbine ☐ Jet ☐ Reciprocating ☐ Centrifugal ☐ Other		
(use a second sheet if needed)						
16 Remarks: elevation				17 Water well contractor's certification: This well was drilled under my jurisdiction and this report is true to the best of my knowledge and belief. <u>Wenger Delg</u> <u>318</u> Business name <u>E I Colverh KS</u> License No. <u>1118</u> Address <u>1975</u> Date <u>11/18</u> Signature <u>Wenger</u>		
Topography: ☐ Hill ☐ Slope ☒ Upland ☐ Valley						

Forward the white, blue and pink copies to the Kansas State Dept. Of Health.

Form WWC-5