USE TYPEWRITER OR BALL POINT PEN-PRESS FIRMLY, PRINT CLEARLY.

T R EW sec 1/4 1/4 1/4 No.

WATER WELL RECORD
KSA 82a-1201-1215

Kansas State Dept. Of Health
(Water Well Contractors)
Forbes-Bldg. 740
Topeka, Kansas 66620

1 Location of well:	County	Township name	Fraction	Section number	Town number	Range number
	Sedgwick	Delano	NW NW NE	30	27S	1W

Distance and direction from nearest town or city: 360 Shefford
Street address of well location if in city: Wichita, Kansas

3 Owner of well: Al Mc Ginnis Inc.
Address: P.O.Box 351 Colwich, Kansas 67030

Locate with "X" in section below:

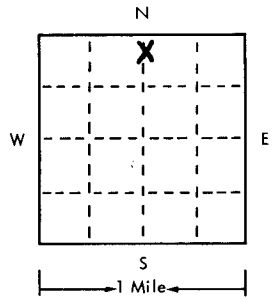

Sketch map:

4 Well depth: 157 ft. Date of completion 4-26-75
Well diameter 11 in.

5 ☐ Cable tool ☒ Rotary ☐ Driven ☐ Dug ☐ Hollow rod ☐ Jetted ☐ Bored ☐ Reverse rotary

6 Use: ☒ Domestic ☐ Public supply ☐ Industry ☐ Irrigation ☐ Air conditioning ☐ Commercial ☐ Test well ☐ ____

7 Casing: Material Styrene Height: above/below ////
Threaded ☐ Welded ☐ Surface 12 in.
Diam. 5 in. to 157 ft. depth Weight ____ lbs./ft.
____ in. to ____ ft. depth Drive shoe? ☐ Yes ☐ No

2 Type and color of material	From	To
Dirt with Clay	0	3
Sandy Clay	3	20
Fine Sand	20	30
Medium Coarse Sand	30	40
Clay	40	110
Fine Sand	110	137
Coarse Sand and Fine gravel	137	157
(use a second sheet if needed)		

8 Screen:
Manufacturer Sunflower Plastic
Type Styrene Dia. 5"
Slot/gauze .005 Length 20'
Set between 137 ft. and 157 ft.
Fittings:
Gravel pack ☒ Yes ☐ No Size range of material 1/4-1/8"

9 Static water level:
25 ft. below land surface Date 4-26-75

10 Pumping level below land surfaces:
____ ft. after ____ hrs. pumping ____ g.p.m.
____ ft. after ____ hrs. pumping ____ g.p.m.
Estimated maximum yield ____ g.p.m.

11 Water sample submitted:
☐ Yes ☐ No Date ____

12 Well head completion:
☒ Pitless adapter 12 ☒ Inches above grade

13 Well grouted? ☒ Yes ☐ No
☒ Neat cement ☐ Bentonite ☐ ____
Depth: From 0 ft. to 12 ft.

14 Nearest source of possible contamination: Sanitary
ft. 50 Direction East Type Sewer
Well disinfected upon completion? ☒ Yes ☐ No

15 Pump: ☐ Not installed
Manufacturer's name Sta-Rite
Model number LP6D2 HP 3/4 Volts 230
Length of drop pipe 50 ft. capacity 20 g.m.p.
Type:
☒ Submersible ☐ Turbine
☐ Jet ☐ Reciprocating
☐ Centrifugal ☐ Other

16 Remarks: elevation
Flat ground

Except for Sanitary Sewer 50 Ft. East.

Topography:
☐ Hill
☐ Slope
☐ Upland
☐ Valley

17 Water well contractor's certification:
This well was drilled under my jurisdiction and this report is true to the best of my knowledge and belief.
Harp Well & Pump Serv. 236
Business name License No.
Address 215 South Tyler Road
Signed Mary Arnold Date 5-14-75
Authorized representative

Forward the white, blue and pink copies to the Kansas State Dept. Of Health.

Form WWC-5

677-H