USE TYPEWRITER OR BALL POINT PEN-PRESS FIRMLY, PRINT CLEARLY.

T R EW sec 1/4 1/4 1/4 No.

WATER WELL RECORD
KSA 82a-1201-1215

Kansas State Dept. Of Health
(Water Well Contractors)
Forbes-Bldg. 740
Topeka, Kansas 66620

1 Location of well:	County	Township name	Fraction	Section number	Town number	Range number
	Sedg.	Delano.	NESESE	30	27S	1W.

Distance and direction from nearest town or city: 2 miles West of Wichita Airport.
Street address of well location if in city: 10413 Skinner

3 Owner of well: Marvin Niedens.
Address: 1320 Reece Rd. Goddard, Ks

Locate with "X" in section below:

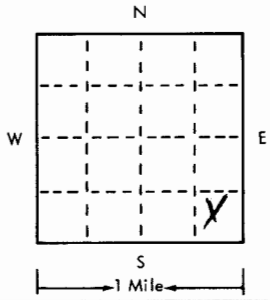

Sketch map:

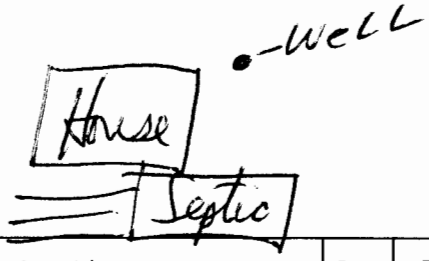

4 Well depth: 65 ft. Date of completion 9/6
Well diameter 5 in.

5 ☐ Cable tool ☑ Rotary ☐ Driven ☐ Dug
☐ Hollow rod ☐ Jetted ☐ Bored ☐ Reverse rotary

6 Use: ☑ Domestic ☐ Public supply ☐ Industry
☐ Irrigation ☐ Air conditioning ☐ Commercial
☐ Test well ☐ _____

7 Casing: Material PVP Height: above/below
Threaded ☐ Welded ☑ Surface 12 in.
Diam. 5 in. to 65 ft. depth Weight 1.50 lbs./ft. 100
___ in. to ___ ft. depth Drive shoe? ☐ Yes ☑ No

8 Screen:
Manufacturer Sunflower
Type Plastic Dia. 5"
Slot/gauze 1/16 Length 5'
Set between 60 ft. and 65.
Fittings:
Gravel pack ☑ Yes ☐ No Size range of material ___

9 Static water level:
30 ft. below land surface Date 9/6.

10 Pumping level below land surfaces:
33 ft. after 1 hrs. pumping 18 g.p.m.
___ ft. after ___ hrs. pumping ___ g.p.m.
Estimated maximum yield 80 g.p.m.

11 Water sample submitted:
☐ Yes ☑ No Date _____

12 Well head completion:
☑ Pitless adapter ☐ 12 inches above grade

13 Well grouted? ☑ Yes ☐ No
☑ Neat cement ☐ Bentonite ☐ _____
Depth: From 3 ft. to 13 ft.

14 Nearest source of possible contamination:
ft. 75 Direction So. Type Septic
Well disinfected upon completion? ☑ Yes ☐ No

15 Pump: ☐ Not installed
Manufacturer's name Valley
Model number 1802 HP 1/2 Volts 230
Length of drop pipe 50 ft. capacity 18 g.m.p.
Type:
☑ Submersible ☐ Turbine
☐ Jet ☐ Reciprocating
☐ Centrifugal ☐ Other

2 Type and color of material	From	To
	0	
Top Soil	0	8
Clay.	8	22
Clay mixed with fine Sand.	22	30
fine Sand to course gravel	30	65

(use a second sheet if needed)

16 Remarks: elevation

Topography:
☐ Hill
☐ Slope
☑ Upland
☐ Valley

17 Water well contractor's certification:
This well was drilled under my jurisdiction and this report is true to the best of my knowledge and belief.
Business name Warner Drlg License No. 318
Address 2 Colwich Ks
Signed [signature] Date 9/6/5
Authorized representative

27 1W 30 NE SE SE

Forward the white, blue and pink copies to the Kansas State Dept. Of Health.

Form WWC-5

677-H