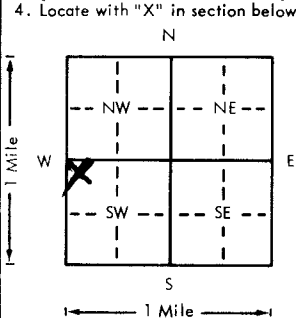


USE TYPEWRITER OR BALL
POINT PEN-PRESS FIRMLY,
PRINT CLEARLY.

WATER WELL RECORD
KSA 82a-1201-1215

Kansas Department of Health and
Environment-Division of Environment
(Water well Contractors)
Topeka, Kansas 66620

1. Location of well:	County <u>Sedgwick</u>	Fraction <u>NW 1/4 NW 1/4 SW 1/4</u>	Section number <u>31</u>	Township number <u>T 27 S</u>	Range number <u>R 1 E</u>
2. Distance and direction from nearest town or city:	3. Owner of well: <u>John Babb</u>				
Street address of well location if in city:	City, state, zip code: <u>2102 So. 119th West Wichita, KS 67209</u>				
4. Locate with "X" in section below:	6. Bore hole dia. <u>11</u> in. Completion date <u>9/28/78</u> Well depth <u>65</u> ft.				
	7. ☐ Cable tool ☒ Rotary ☐ Driven ☐ Dug ☐ Hollow rod ☐ Jetted ☐ Bored ☐ Reverse rotary				
	8. Use: ☒ Domestic ☐ Public supply ☐ Industry ☐ Irrigation ☐ Air conditioning ☐ Stock ☐ Lawn ☐ Oil field water ☐ Other				
5. Type and color of material	9. Casing: Material <u>Steel</u> Weight: <u>13</u> lbs./ft. Threading <u>Welded</u> Surface <u>13</u> in. RMP <u>X</u> PVC <u>Weight 130 lbs./ft.</u> Dia. <u>5</u> in. <u>65</u> ft. depth Wall Thickness: inches or Dia. <u>in.</u> to <u>ft.</u> depth gage No. <u>200</u>				
<u>Top soil.</u>	From <u>0</u>	To <u>2</u>	10. Screen: Manufacturer's name <u>Sumflower</u>		
<u>red clay.</u>	<u>2</u>	<u>31</u>	Type <u>200</u> Dia. <u>5</u> in.		
<u>fine-med sand.</u>	<u>31</u>	<u>49</u>	Slot gauge <u>1 1/2</u> Length <u>8</u> ft.		
<u>black clay.</u>	<u>49</u>	<u>50</u>	Set between <u>15</u> ft. and <u>65</u> ft.		
<u>med. sand.</u>	<u>50</u>	<u>57</u>	Grovel pack? <u>Yes</u> Size range of material <u>3/8</u>		
<u>black clay.</u>	<u>57</u>	<u>65</u>	11. Static water level: <u>30</u> ft. below land surface Date <u>9/28/78</u>		
			12. Pumping level below land surfaces: <u>40</u> ft. after <u>1/2</u> hrs. pumping <u>10</u> g.p.m. <u>40</u> ft. after <u>1</u> hrs. pumping <u>10</u> g.p.m. Estimated maximum yield <u>15-20</u> g.p.m.		
			13. Water sample submitted: <u>Yes</u> ☒ No ☐ Date <u>9/28/78</u>		
			14. Well head completion: ☒ Pitless adapter <u>12</u> inches above grade		
			15. Well grouted? <u>Yes</u> With: <u>Neat cement</u> ☐ Bentonite ☒ Concrete <u>X</u> Depth: From <u>31</u> ft. to <u>13</u> ft.		
			16. New source of possible contamination: ft. <u>70</u> Direction <u>W. Septic</u> Well disinfected upon completion? ☒ Yes ☐ No		
			17. Pump: Manufacturer's name <u>Valley</u> Not installed Model number <u>1800</u> HP <u>3/4</u> Volts <u>220</u> Length of drop pipe <u>45</u> ft. capacity <u>12</u> g.p.m. Type: ☒ Submersible ☐ Turbine ☐ Jet ☐ Reciprocating ☐ Centrifugal ☐ Other		
18. Elevation:	19. Remarks: <u>Customer to furnish 4x4x4 slab around casing at grade</u> <u>Per State Regulations</u> <u>Signed John E. Babb</u>				
Topography: ☐ Hill ☐ Slope ☒ Upland ☐ Valley	20. Water well contractor's certification: This well was drilled under my jurisdiction and this report is true to the best of my knowledge and belief. <u>Whitney Dyll</u> <u>318</u> Business name <u>Polwich</u> License No. <u>9/28/78</u> Address <u>Polwich</u> Signature <u>Whitney Dyll</u> Authorized representative				

Forward the white, blue and pink copies to the Department of Health and Environment

Form WWC-5