


1 LOCATION OF WATER WELL: Fraction SW 1/4 NE 1/4 NE 1/4 Section Number 31 Township Number T 27 S Range Number R 1 E

County: Sedgwick Distance and direction from nearest town or city street address of well if located within city?

See Below

2 WATER WELL OWNER: Charles Schmidt Board of Agriculture, Division of Water Resources  
RR#, St. Address, Box #: 10615 Carr Wichita KS 67209 Application Number:

3 LOCATE WELL'S LOCATION WITH AN "X" IN SECTION BOX: 4 DEPTH OF COMPLETED WELL 58 ft. ELEVATION:

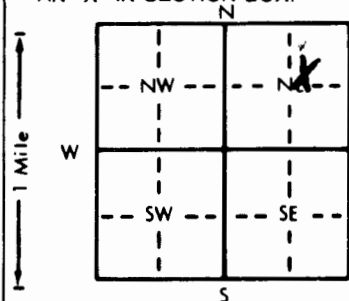

Depth(s) Groundwater Encountered 1. 27 ft. 2. 27 ft. 3. 27 ft.  
WELL'S STATIC WATER LEVEL 27 ft. below land surface measured on 6-22-91  
Pump test data: Well water was 27 ft. after 1/2 hours pumping 20 gpm  
Est. Yield 70 gpm: Well water was 27 ft. after 1/2 hours pumping 20 gpm  
Bore Hole Diameter 11 in. to 58 ft. and 58 in. to 58 ft.  
WELL WATER TO BE USED AS: 5 Public water supply 8 Air conditioning 11 Injection well  
1 Domestic 3 Feedlot 6 Oil field water supply 9 Dewatering 12 Other (Specify below)  
2 Irrigation 4 Industrial 7 Lawn and garden only 10 Monitoring well  
Was a chemical/bacteriological sample submitted to Department? Yes X No X If yes, mo/day/yr sample was submitted

5 TYPE OF BLANK CASING USED: 1 Steel 3 RMP (SR) 5 Wrought iron 8 Concrete tile CASING JOINTS: Glued X Clamped  
2 PVC 4 ABS 6 Asbestos-Cement 9 Other (specify below) Welded X  
Casing height above land surface 12 in. weight 2.60 lbs./ft. Wall thickness or gauge No. 160 PVC  
TYPE OF SCREEN OR PERFORATION MATERIAL: 7 PVC 10 Asbestos-cement  
1 Steel 3 Stainless steel 5 Fiberglass 8 RMP (SR) 11 Other (specify)  
2 Brass 4 Galvanized steel 6 Concrete tile 9 ABS 12 None used (open hole)

SCREEN OR PERFORATION OPENINGS ARE: 5 Gauzed wrapped 8 Saw cut 11 None (open hole)  
1 Continuous slot 3 Mill slot 6 Wire wrapped 9 Drilled holes  
2 Louvered shutter 4 Key punched 7 Torch cut 10 Other (specify)

SCREEN-PERFORATED INTERVALS: From 50 ft. to 58 ft. From 50 ft. to 58 ft. From 50 ft. to 58 ft. From 50 ft. to 58 ft.  
GRAVEL PACK INTERVALS: From 20 ft. to 58 ft. From 20 ft. to 58 ft. From 20 ft. to 58 ft. From 20 ft. to 58 ft.

6 GROUT MATERIAL: 1 Neat cement 2 Cement grout 3 Bentonite 4 Other  
Grout Intervals: From 3 ft. to 20 ft. From 20 ft. to 58 ft. From 58 ft. to 58 ft. From 58 ft. to 58 ft.  
What is the nearest source of possible contamination: 10 Livestock pens 14 Abandoned water well  
1 Septic tank 4 Lateral lines 7 Pit privy 11 Fuel storage 15 Oil well/Gas well  
2 Sewer lines 5 Cess pool 8 Sewage lagoon 12 Fertilizer storage 16 Other (specify below)  
3 Watertight sewer lines 6 Seepage pit 9 Feedyard 13 Insecticide storage

Direction from well? South How many feet? 60

FROM TO LITHOLOGIC LOG FROM TO PLUGGING INTERVALS

0 2 Top so.  
2 19 CLAY.  
19 28 SAND.  
28 34 CLAY.  
34 58 fine to med SAND  
58 - CLAY

7 CONTRACTOR'S OR LANDOWNER'S CERTIFICATION: This water well was (1) constructed, (2) reconstructed, or (3) plugged under my jurisdiction and was completed on (mo/day/year) 6-22-91 and this record is true to the best of my knowledge and belief. Kansas  
Water Well Contractor's License No. 318 This Water Well Record was completed on (mo/day/yr) 6-22-91  
under the business name of Wenger Dull by (signature) [Signature]