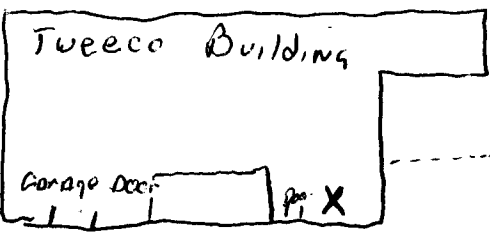


USE TYPEWRITER OR BALL
POINT PEN-PRESS FIRMLY,
PRINT CLEARLY.

WATER WELL RECORD
KSA 82a-1201-1215

Kansas Department of Health and
Environment-Division of Environment
(Water well Contractors)
Topeka, Kansas 66620

TWECO

1. Location of well:		County SEDGWICK	Fraction NW 1/4 NE 1/4 NE 1/4	Section number 35	Township number 21 N	Range number 10 W
2. Distance and direction from nearest town or city: Street address of well location if in city: 4200 W. HARRY		3. Owner of well: TWECO PRODUCTS R.R. or street: 4200 W. HARRY City, state, zip code: WICHITA KS.				
4. Locate with "X" in section below: N W E S 1 Mile		Sketch map: 				
5. Type and color of material		From	To	6. Bore hole dia. 1 1/2 in. Completion date 9-27-77 Well depth 35 ft.		
Topsoil		0	10	7. Cable tool ☐ Rotary ☐ Driven ☐ Dug ☐ Hollow rod ☐ Jetted ☒ Bored ☐ Reverse rotary ☐		
Sand fine		10	20	8. Use: Domestic ☐ Public supply ☐ Industry ☐ Irrigation ☐ Air conditioning ☒ Stock ☐ Lawn ☐ Oil field water ☐ Other ☐		
GRAVEL - COARSE		25	35	9. Casing: Material Steel Weight: Above or below Threaded ☐ Welded ☒ Surface 12 in. RMP ☐ PVC ☐ Weight 1.5 lbs./ft. Dia. 5 in. to 35 ft. depth Wall Thickness: inches or Dia. ☐ in. to ☐ ft. depth Gauge No. 1200		
				10. Screen: Manufacturer's name J&L Type 100 Dia. 5" Slot/gauze 1.065 Length 1 Set between 30 ft. and 35 ft. ft. and ☐ ft. Gravel pack? NO Size range of material ☐		
				11. Static water level: ☐ mo./day/yr. 15 ft. below land surface Date 9-2-77		
				12. Pumping level below land surfaces: 15 ft. after 1 hrs. pumping 30 g.p.m. ft. after ☐ hrs. pumping ☐ g.p.m. Estimated maximum yield 75 g.p.m.		
				13. Water sample submitted: ☐ mo./day/yr. Yes ☒ No ☐ Date ☐		
				14. Well head completion: Pitless adapter 12 inches above grade		
				15. Well grouted? YES With: Neat cement ☐ Bentonite ☒ Concrete ☐ Depth: From 0 ft. to 10 ft.		
				16. Nearest source of possible contamination: ft. 200 Direction N Type SEWER Well disinfected upon completion? ☒ Yes ☐ No ☐		
				17. Pump: ☒ Not installed Manufacturer's name ☐ Model number ☐ HP ☐ Volts ☐ Length of drop pipe ☐ ft. capacity ☐ g.p.m. Type: ☐ Submersible ☐ Turbine ☐ Jet ☐ Reciprocating ☐ Centrifugal ☐ Other ☐		
		(Use a second sheet if needed)				
18. Elevation: Topography: ☐ Hill ☐ Slope ☒ Upland ☐ Valley		19. Remarks:				20. Water well contractor's certification: This well was drilled under my jurisdiction and this report is true to the best of my knowledge and belief. 21st Electric Co 129 Business name 512 W. 21st License No. Address Wichita, KS Signed J. H. Hume Date 9-20-77 Authorized representative

Forward the white, blue and pink copies to the Department of Health and Environment

Form WWC-5