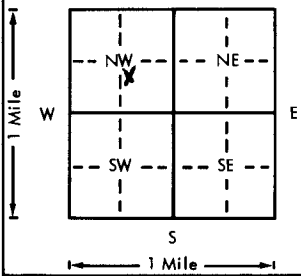


USE TYPEWRITER OR BALL
POINT PEN-PRESS FIRMLY,
PRINT CLEARLY.

WATER WELL RECORD
KSA 82a-1201-1215

Kansas Department of Health and
Environment-Division of Environment
(Water well Contractors)
Topeka, Kansas 66620

1. Location of well:		County Sedgwick	Fraction 1/4 SE 1/4 NW/4	Section number 36	Township number T 27 S	Range number R 1WE/W
2. Distance and direction from nearest town or city: Street address of well location if in city: Esthner & Knight Wichita, Kansas			3. Owner of well: John McKay R.R. or street: 302 North Main City, state, zip code: Wichita, Kansas 67202			
4. Locate with "X" in section below: Sketch map: 			6. Bore hole dia. 14 in. Completion date 10-27-77 Well depth 65 ft.			
5. Type and color of material			7. ☐ Cable tool ☒ Rotary ☐ Driven ☐ Dug ☐ Hollow rod ☐ Jetted ☐ Bored ☐ Reverse rotary			
			8. Use: ☐ Domestic ☐ Public supply ☐ Industry ☐ Irrigation ☒ Air conditioning ☐ Stock ☐ Lawn ☐ Oil field water ☐ Other			
			9. Casing: Material PVC Height: Above or below Threaded ☐ Welded ☒ Surface 12 in. RMP 8 PVC ☒ Weight 5.47 lbs./ft. Dia. 8 in. to 65 ft. depth Wall Thickness: inches or Dia. 8 in. to 65 ft. depth gage No. 322			
			10. Screen: Manufacturer's name PVC NSF approved 160 PSI Type PVC 160 PSI Dia. 8" Slot/groove .06 Length 15' Set between 50 ft. and 65 ft. yes ft. and 1/4-1/8 ft. Gravel pack? ☐ Size range of material			
			11. Static water level: 15 ft. below land surface Date 10-27-77 mo./day/yr.			
(Use a second sheet if needed)			12. Pumping level below land surfaces: ____ ft. after ____ hrs. pumping ____ g.p.m. ____ ft. after ____ hrs. pumping ____ g.p.m. Estimated maximum yield ____ g.p.m.			
			13. Water sample submitted: ____ mo./day/yr. Yes ☐ No ☐ Date			
			14. Well head completion: 12 capped ____ Pitless adapter 12 inches above grade			
			15. Well grouted? yes 1-2 fine sand mix With: ☐ Neat cement ☐ Bentonite ☒ Concrete Depth: From 40 ft. to 14 ft.			
			16. Nearest source of possible contamination: NONE ft. ____ Direction ____ Type ____ Well disinfected upon completion? ☒ Yes ☐ No			
18. Elevation: Topography: ☐ Hill ☐ Slope ☐ Upland ☐ Valley			17. Pump: ☒ Not installed Manufacturer's name ____ Model number ____ HP ____ Volts ____ Length of drop pipe ____ ft. capacity ____ g.p.m. Type: ☐ Submersible ☐ Turbine ☐ Jet ☐ Reciprocating ☐ Centrifugal ☐ Other			
			20. Water well contractor's certification: This well was drilled under my jurisdiction and this report is true to the best of my knowledge and belief. Harp Well & Pump 236 Business name License No. Address Wichita, Kansas Signed M. Arnold Date 12-22-77 Authorized representative			
			19. Remarks: Flat Ground Septic system not installed at this time. No apparent source for contamination. Pump not installed at this time.			

Forward the white, blue and pink copies to the Department of Health and Environment

Form WWC-5