

1 LOCATION OF WATER WELL: County: <u>SEDGWICK</u>	Fraction: <u>NW 1/4 NE 1/4 SW 1/4</u>	Section Number: <u>36</u>	Township Number: <u>T 27 S</u>	Range Number: <u>R 1 E</u>
--	---------------------------------------	---------------------------	--------------------------------	----------------------------

Distance and direction from nearest town or city street address of well if located within city?

1905 SW BLVD WICHITA, KS

2 WATER WELL OWNER: KARL KESSLER & ETAL


RR#, St. Address, Box #: 1905 SW BLVD

City, State, ZIP Code: WICHITA, KS 67213

Board of Agriculture, Division of Water Resources

Application Number:

3 LOCATE WELL'S LOCATION WITH AN "X" IN SECTION BOX:

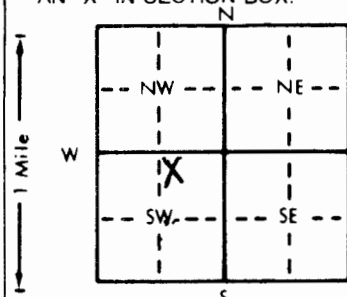

4 DEPTH OF COMPLETED WELL: 15 ft. ELEVATION:






WELL WATER TO BE USED AS: 5 Public water supply 8 Air conditioning 11 Injection well

1 Domestic 3 Feedlot 6 Oil field water supply 9 Dewatering 12 Other (Specify below)

2 Irrigation 4 Industrial 7 Lawn and garden only 10 Monitoring well

Was a chemical/bacteriological sample submitted to Department? Yes No If yes, mo/day/yr sample was submitted

Water Well Disinfected? Yes No

5 TYPE OF BLANK CASING USED:

- 1 Steel 3 RMP (SR)
2 PVC 4 ABS


Casing height above land surface: FLUSH in. weight: 703 lbs./ft. Wall thickness or gauge No. 154

TYPE OF SCREEN OR PERFORATION MATERIAL:

- 1 Steel 3 Stainless steel 5 Fiberglass 8 RMP (SR) 11 Other (specify)
2 Brass 4 Galvanized steel 6 Concrete tile 9 ABS 12 None used (open hole)

SCREEN OR PERFORATION OPENINGS ARE:

- 1 Continuous slot 3 Mill slot 5 Gauzed wrapped 8 Saw cut 11 None (open hole)
2 Louvered shutter 4 Key punched 6 Wire wrapped 9 Drilled holes 12 Other (specify)
7 Torch cut



6 GROUT MATERIAL:

- 1 Neat cement 2 Cement grout 3 Bentonite 4 Other


What is the nearest source of possible contamination:

- 1 Septic tank 4 Lateral lines 7 Pit privy 11 Fuel storage 14 Abandoned water well
2 Sewer lines 5 Cess pool 8 Sewage lagoon 12 Fertilizer storage 15 Oil well/Gas well
3 Watertight sewer lines 6 Seepage pit 9 Feedyard 13 Insecticide storage 16 Other (specify below)

Direction from well? SE

How many feet? 115

FROM	TO	LITHOLOGIC LOG	FROM	TO	PLUGGING INTERVALS
0	3.5	FILL CLAY, SILT			
3.5	9.0	CLAY, SILT, SAND			
9.0	15.0	SAND			

NOTE: ALLISON IRWIN CONTACTED DON TAYLOR ABOUT REPORTS BEING TURNED IN LATE ON 3-4-94 @ 10:00 A.M.

7 CONTRACTOR'S OR LANDOWNER'S CERTIFICATION: This water well was (1) constructed (2) reconstructed, or (3) plugged under my jurisdiction and was completed on (mo/day/year) 3-2-94 and this record is true to the best of my knowledge and belief. Kansas

Water Well Contractor's License No. 531 This Water Well Record was completed on (mo/day/yr) 5-19-94

under the business name of GSI by (signature) Mike Thompson