


1 LOCATION OF WATER WELL: County: **SEDGWICK** Fraction: **NW 1/4 NW 1/4 SW 1/4** Section Number: **12** Township Number: **T 27S S** Range Number: **R 1W E/W**

Distance and direction from nearest town or city street address of well if located within city?  
**1627 N. WESTRIDGE**

2 WATER WELL OWNER: **SCOTT SORENSEN** NOTE: WELL WAS LOCATED IN GARAGE  
RR#, St. Address, Box #: **1627 N. WESTRIDGE** Board of Agriculture, Division of Water Resources  
City, State, ZIP Code: **WICHITA KS 67203** Application Number:

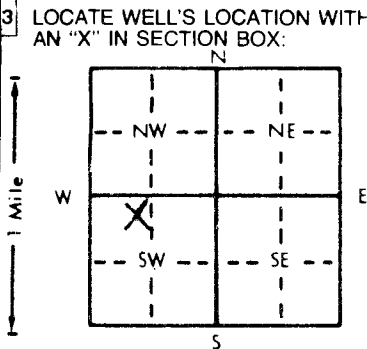

4 DEPTH OF COMPLETED WELL: **12** ft. ELEVATION: \_\_\_\_\_  
Depth(s) Groundwater Encountered: 1. \_\_\_\_\_ ft. 2. \_\_\_\_\_ ft. 3. \_\_\_\_\_ ft.  
WELL'S STATIC WATER LEVEL: **DRY/12** ft. below land surface measured on mo/day/yr: **8/4/94**  
Pump test data: Well water was \_\_\_\_\_ ft. after \_\_\_\_\_ hours pumping \_\_\_\_\_ gpm  
Est. Yield \_\_\_\_\_ gpm: Well water was \_\_\_\_\_ ft. after \_\_\_\_\_ hours pumping \_\_\_\_\_ gpm  
Bore Hole Diameter \_\_\_\_\_ in. to \_\_\_\_\_ ft., and \_\_\_\_\_ in. to \_\_\_\_\_ ft.  
WELL WATER TO BE USED AS:  
1 Domestic  3 Feedlot  5 Public water supply  8 Air conditioning  11 Injection well   
2 Irrigation  4 Industrial  6 Oil field water supply  9 Dewatering  12 Other (Specify below) \_\_\_\_\_  
7 **Lawn and garden only**  10 Monitoring well   
Was a chemical/bacteriological sample submitted to Department? Yes \_\_\_\_\_ No  If yes, mo/day/yr sample was submitted \_\_\_\_\_  
Water Well Disinfected? Yes  No \_\_\_\_\_

5 TYPE OF BLANK CASING USED:  
1 **Steel**  3 RMP (SR) \_\_\_\_\_  
2 PVC \_\_\_\_\_ 4 ABS \_\_\_\_\_  
Blank casing diameter: **2 1/2** in. to \_\_\_\_\_ ft., Dia. \_\_\_\_\_ in. to \_\_\_\_\_ ft., Dia. \_\_\_\_\_ in. to \_\_\_\_\_ ft.  
Casing height above land surface: \_\_\_\_\_ in., weight \_\_\_\_\_ lbs./ft. Wall thickness or gauge No. \_\_\_\_\_  
TYPE OF SCREEN OR PERFORATION MATERIAL:  
1 Steel  3 Stainless steel \_\_\_\_\_ 5 Fiberglass \_\_\_\_\_ 7 PVC \_\_\_\_\_ 10 Asbestos-cement \_\_\_\_\_  
2 Brass \_\_\_\_\_ 4 Galvanized steel \_\_\_\_\_ 6 Concrete tile \_\_\_\_\_ 8 RMP (SR) \_\_\_\_\_ 11 Other (specify) **NA** \_\_\_\_\_  
9 ABS \_\_\_\_\_ 12 None used (open hole) \_\_\_\_\_  
SCREEN OR PERFORATION OPENINGS ARE:  
1 Continuous slot \_\_\_\_\_ 3 Mill slot \_\_\_\_\_ 5 Gauzed wrapped \_\_\_\_\_ 8 Saw cut \_\_\_\_\_ 11 None (open hole) \_\_\_\_\_  
2 Louvered shutter \_\_\_\_\_ 4 Key punched \_\_\_\_\_ 6 Wire wrapped \_\_\_\_\_ 9 Drilled holes \_\_\_\_\_  
7 Torch cut \_\_\_\_\_ 10 Other (specify) **NA** \_\_\_\_\_  
SCREEN-PERFORATED INTERVALS: From **NA** ft. to **NA** ft., From \_\_\_\_\_ ft. to \_\_\_\_\_ ft.  
GRAVEL PACK INTERVALS: From \_\_\_\_\_ ft. to \_\_\_\_\_ ft., From \_\_\_\_\_ ft. to \_\_\_\_\_ ft.

6 GROUT MATERIAL: 1 Neat cement \_\_\_\_\_ 2 **Cement grout**  3 Bentonite \_\_\_\_\_ 4 Other \_\_\_\_\_  
Grout intervals: From **12** ft. to \_\_\_\_\_ ft., From \_\_\_\_\_ ft. to \_\_\_\_\_ ft., From \_\_\_\_\_ ft. to \_\_\_\_\_ ft.  
What is the nearest source of possible contamination:  
1 Septic tank \_\_\_\_\_ 4 Lateral lines \_\_\_\_\_ 7 Pit privy \_\_\_\_\_ 10 Livestock pens \_\_\_\_\_ 14 Abandoned water well \_\_\_\_\_  
2 Sewer lines \_\_\_\_\_ 5 Cess pool \_\_\_\_\_ 8 Sewage lagoon \_\_\_\_\_ 11 Fuel storage \_\_\_\_\_ 15 Oil well/Gas well \_\_\_\_\_  
3 Watertight sewer lines \_\_\_\_\_ 6 Seepage pit \_\_\_\_\_ 9 Feedyard \_\_\_\_\_ 12 Fertilizer storage \_\_\_\_\_ 16 **Other (specify below)** \_\_\_\_\_  
**WELL WAS DRY.**  
Direction from well? **SOUTH** **FOUNDATION WALL** How many feet? **LOCATED IN GARAGE FLOOR**

FROM	TO	LITHOLOGIC LOG	FROM	TO	PLUGGING INTERVALS
			<b>12</b>	<b>0</b>	<b>CEMENT GROUT</b>

7 CONTRACTOR'S OR LANDOWNER'S CERTIFICATION: This water well was (1) constructed, (2) reconstructed, or (3) **plugged** under my jurisdiction and was completed on (mo/day/year) **8/4/94** and this record is true to the best of my knowledge and belief. Kansas Water Well Contractor's License No. \_\_\_\_\_ This Water Well Record was completed on (mo/day/yr) **8/4/94** under the business name of \_\_\_\_\_ by (signature) **Scott Sorensen**

OFFICE USE ONLY  
T  
R  
EW  
SEC.