


SW SW SW NE

1 LOCATION OF WATER WELL: Sedgwick	FRACTION SE 1/4 SE 1/4 NW 1/4	Section Number 7	Township Number T 27 S	Range Number R 1W E/W
--	---	----------------------------	----------------------------------	---------------------------------

Distance and direction from nearest town or city street address of well if located within city?

1807 N. Parkdale Wichita, Kansas

2 WATER WELL OWNER: GERMAN, Bill RR#, ST. ADDRESS, BOX #: 1807 N. Parkdale CITY, STATE, ZIP CODE: Wichita, Kansas	Board of Agriculture, Division of Water Resource Application Number:
---	---

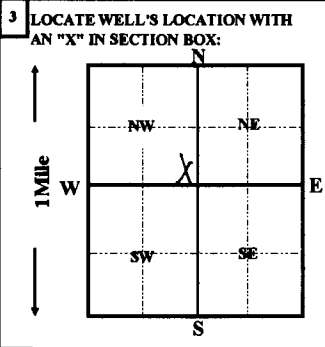

4 DEPTH OF COMPLETED WELL 60 ft. ELEVATION:	Depth(s) groundwater Encountered 1 ft. 2 ft. 3 ft.
WELL'S STATIC WATER LEVEL 25 FT. BELOW LAND SURFACE MEASURED ON 08/11/1994	
Pump test data: Well water was _____ ft. after _____ hours pumping _____ gpm	
Est. Yield _____ gpm: Well water was _____ ft. after _____ hours pumping _____ gpm	
Bore Hole Diameter 12 in. to 60 ft. and _____ in. to _____ ft.	
WELL WATER TO BE USED AS:	5 Public water supply 8 Air conditioning 11 Injection well
1 Domestic 3 Feedlot 6 Oil field water supply 9 Dewatering 12 Other (Specify below)	
2 Irrigation 4 Industrial 7 Lawn and garden only 10 Monitoring well	
Was a chemical/bacteriological sample submitted to Department? Yes _____ No <input checked="" type="checkbox"/> ; If yes, mo/day/yr sample was submitted _____	Water Well Disinfected? Yes <input checked="" type="checkbox"/> No _____

5 TYPE OF CASING USED:	5 Wrought iron 8 Concrete tile CASING JOINTS: Glued <input checked="" type="checkbox"/> Clamped
1 Steel 3 RMP (SR) 6 Asbestos-Cement 9 Other (Specify below)	Welded
2 PVC 4 ABS 7 Fiberglass SDR-26 Threaded	
Blank casing Diameter 5 in. to 40 ft., Dia _____ in. to _____ ft.	Wall thickness or gauge No. .214
Casing height above land surface 12 in., weight 2.35 lbs. / ft.	
TYPE OF SCREEN OR PERFORATION MATERIAL:	7 PVC 10 Asbestos-cement
1 Steel 3 Stainless Steel 5 Fiberglass 8 RMP (SR) 11 other (specify)	
2 Brass 4 Galvanized steel 6 Concrete tile 9 ABS 12 None used (open hole)	
SCREEN OR PERFORATION OPENING ARE:	8 Saw cut 11 None (open hole)
1 Continous slot 3 Mill slot 6 Wire wrapped 9 Drilled holes	
2 Louvered shutter 4 Key punched 7 Torch cut 10 Other (specify)	
SCREEN-PERFORATION INTERVALS: from 40 ft. to 60 ft., From _____ ft. to _____ ft.	
GRAVEL PACK INTERVALS: from 24 ft. to 60 ft., From _____ ft. to _____ ft.	

6 GROUT MATERIAL: 1 Neat cement 2 Cement grout 3 Bentonite 4 Other	
Grout Intervals: From 4 ft. to 24 ft. From _____ ft. to _____ ft.	
What is the nearest source of possible contamination:	10 Livestock pens 14 Abandon water well
1 Septic tank 4 Lateral lines 7 Pit privy 11 Fuel storage 15 Oil well/Gas well	
2 Sewer lines 5 Cess pool 8 Sewage lagoon 12 Fertilizer storage 16 Other (specify below)	
3 Watertight sewer lines 6 Seepage pit 9 Feedyard 13 Insecticide storage	
Direction from well? West How many feet? 15	

FROM	TO	LITHOLOGIC LOG	FROM	TO	PLUGGING INTERVALS
0	3	topsoil			
3	18	clay			
18	29	fine sand			
29	60	medium sand			

7 CONTRACTOR'S OR LANDOWNER'S CERTIFICATION: This water well was (1) constructed, (2) reconstructed, or (3) plugged under my jurisdiction and was completed on (mo/day/year) 08/11/1994 and this record is true to the best of my knowledge and belief. Kansas Water Well Contractor's License No. 236 This Water Well Record was completed on (mo/day/yr) 08/13/94 Under the business name of Harp Well & Pump Service, Inc. by (signature) <i>Jane Frederick</i>
