


Plugging Report

1 LOCATION OF WATER WELL: Fraction SE 1/4 SW 1/4 NW 1/4 Section Number 25 Township Number T 27 Range Number R 1 EW EW
 County: Saline
 Distance and direction from nearest town or city street address of well if located within city?

614 S McComas

2 WATER WELL OWNER: Mr Bloom
 RR#, St. Address, Box #: 614 S McComas
 City, State, ZIP Code: Wichita Kansas 67213
 Board of Agriculture, Division of Water Resources
 Application Number: none

3 LOCATE WELL'S LOCATION WITH AN "X" IN SECTION BOX: 4 DEPTH OF COMPLETED WELL 25 ft. ELEVATION: 1300
 Depth(s) Groundwater Encountered 1. 15 ft. 2. _____ ft. 3. _____ ft.

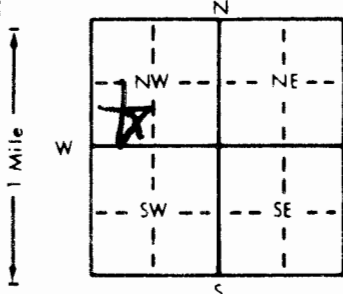

WELL'S STATIC WATER LEVEL 15 ft. below land surface measured on mo/day/yr 10-14-94

Pump test data: Well water was _____ ft. after _____ hours pumping _____ gpm

Est. Yield _____ gpm: Well water was _____ ft. after _____ hours pumping _____ gpm

Bore Hole Diameter was _____ in. to _____ ft., and _____ in. to _____ ft.

WELL WATER TO BE USED AS: 5 Public water supply 8 Air conditioning 11 Injection well

1 Domestic 3 Feedlot 6 Oil field water supply 9 Dewatering 12 Other (Specify below)

2 Irrigation 4 Industrial 7 Lawn and garden only 10 Monitoring well

Was a chemical/bacteriological sample submitted to Department? Yes _____ No _____; If yes, mo/day/yr sample was submitted

Water Well Disinfected? Yes _____ No _____

5 TYPE OF BLANK CASING USED: 5 Wrought iron 8 Concrete tile CASING JOINTS: Glued _____ Clamped _____

1 Steel 3 RMP (SR) 6 Asbestos-Cement 9 Other (specify below) Welded _____

2 PVC 4 ABS 7 Fiberglass Threaded ✓

Blank casing diameter 5 1/2 in. to _____ ft. Dia _____ in. to _____ ft. Dia _____ in. to _____ ft.

Casing height above land surface 36 in., weight _____ lbs./ft. Wall thickness or gauge No. _____

TYPE OF SCREEN OR PERFORATION MATERIAL: 7 PVC 10 Asbestos-cement

1 Steel 3 Stainless steel 5 Fiberglass 8 RMP (SR) 11 Other (specify)

2 Brass 4 Galvanized steel 6 Concrete tile 9 ABS 12 None used (open hole)

SCREEN OR PERFORATION OPENINGS ARE: 5 Gauzed wrapped 8 Saw cut 11 None (open hole)

1 Continuous slot 3 Mill slot 6 Wire wrapped 9 Drilled holes Sand Point

2 Louvered shutter 4 Key punched 7 Torch cut 10 Other (specify)

SCREEN-PERFORATED INTERVALS: From NK ft. to NK ft., From _____ ft. to _____ ft.

From _____ ft. to _____ ft., From _____ ft. to _____ ft.

GRAVEL PACK INTERVALS: From _____ ft. to _____ ft., From _____ ft. to _____ ft.

From _____ ft. to _____ ft., From _____ ft. to _____ ft.

6 GROUT MATERIAL: 1 Neat cement 2 Cement grout 3 Bentonite 4 Other

Grout Intervals: From 15 ft. to 0 ft., From _____ ft. to _____ ft., From _____ ft. to _____ ft.

What is the nearest source of possible contamination: 10 Livestock pens 14 Abandoned water well

1 Septic tank 4 Lateral lines 7 Pit privy 11 Fuel storage 15 Oil well/Gas well

2 Sewer lines 5 Cess pool 8 Sewage lagoon 12 Fertilizer storage 16 Other (specify below)

3 Watertight sewer lines 6 Seepage pit 9 Feedyard 13 Insecticide storage

Direction from well? North How many feet? 2

FROM TO LITHOLOGIC LOG FROM TO PLUGGING INTERVALS

15 0 Cement grout

Pulled & Plugged
 Sand Point well

7 CONTRACTOR'S OR LANDOWNER'S CERTIFICATION: This water well was (1) constructed, (2) reconstructed, or (3) plugged under my jurisdiction and was

completed on (mo/day/year) 10-14-94 and this record is true to the best of my knowledge and belief. Kansas

Water Well Contractor's License No. 472 This Water Well Record was completed on (mo/day/yr) 10-14-94

under the business name of Bearden Pump & Well by (signature) David R Bearden