

1 LOCATION OF WATER WELL:	Fraction	Section Number	Township Number	Range Number
County: <u>SEDGWICK</u>	<u>SW 1/4 SW 1/4 SW 1/4</u>	<u>24</u>	<u>T 27 S</u>	<u>R 1 E</u>

Distance and direction from nearest town or city street address of well if located within city?

240 S. WEST ST., WICHITA, KSMW - 04

2 WATER WELL OWNER: TOWN & COUNTRY"

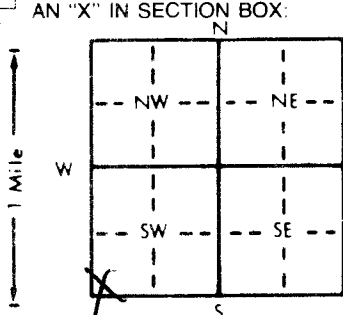
RR#, St. Address, Box # : 240 S. WEST ST.

Board of Agriculture, Division of Water Resources

City, State, ZIP Code : WICHITA, KS 67201

Application Number:

3 LOCATE WELL'S LOCATION WITH AN "X" IN SECTION BOX:

4 DEPTH OF COMPLETED WELL 20 ft. ELEVATION: 1304.91Depth(s) Groundwater Encountered 1. 1290.75 ft. 2. 19.16 ft. 3. 4/1/94 ft.WELL'S STATIC WATER LEVEL 1290.75 ft. below land surface measured on mo/day/yr 4/1/94Pump test data: Well water was 7.75 in. to 20 ft. after 10 hours pumping 10 gpmEst. Yield 10 gpm: Well water was 7.75 in. to 20 ft. after 10 hours pumping 10 gpmBore Hole Diameter 7.75 in. to 20 ft. and 10 in. to 10 ft.

WELL WATER TO BE USED AS: 5 Public water supply 8 Air conditioning 11 Injection well

1 Domestic 3 Feedlot 6 Oil field water supply 9 Dewatering 12 Other (Specify below)

2 Irrigation 4 Industrial 7 Lawn and garden only 10 Monitoring wellWas a chemical/bacteriological sample submitted to Department? Yes No X; If yes, mo/day/yr sample was submittedWater Well Disinfected? Yes No X

5 TYPE OF BLANK CASING USED:

5 Wrought iron

8 Concrete tile

CASING JOINTS: Glued Clamped

1 Steel

3 RMP (SR)

6 Asbestos-Cement

9 Other (specify below)

Welded

2 PVC

4 ABS

7 Fiberglass

Threaded XBlank casing diameter 2 in. to 10 ft. Dia 10 in. to 10 ft. Dia 10 in. to 10 ft.Casing height above land surface NA in., weight NA lbs./ft. Wall thickness or gauge No. NA

TYPE OF SCREEN OR PERFORATION MATERIAL:

1 Steel

3 Stainless steel

5 Fiberglass

7 PVC

10 Asbestos-cement

2 Brass

4 Galvanized steel

6 Concrete tile

8 RMP (SR)

11 Other (specify)

9 ABS

12 None used (open hole)

SCREEN OR PERFORATION OPENINGS ARE:

1 Continuous slot

3 Mill slot

5 Gauzed wrapped

8 Saw cut

11 None (open hole)

2 Louvered shutter

4 Key punched

6 Wire wrapped

9 Drilled holes

7 Torch cut

10 Other (specify)

SCREEN-PERFORATED INTERVALS: From 10 ft. to 19.5 ft. From 10 ft. to 19.5 ft.From 10 ft. to 19.5 ft. From 10 ft. to 19.5 ft.GRAVEL PACK INTERVALS: From 8 ft. to 20 ft. From 8 ft. to 20 ft.From 8 ft. to 20 ft. From 8 ft. to 20 ft.

6 GROUT MATERIAL:

1 Neat cement

2 Cement grout3 Bentonite

4 Other

Grout Intervals: From 0 ft. to 6 ft. From 6 ft. to 8 ft. From 6 ft. to 8 ft.

What is the nearest source of possible contamination:

1 Septic tank

4 Lateral lines

7 Pit privy

10 Livestock pens

14 Abandoned water well

2 Sewer lines

5 Cess pool

8 Sewage lagoon

14 Fuel storage

15 Oil well/Gas well

3 Watertight sewer lines

6 Seepage pit

9 Feedyard

12 Fertilizer storage

16 Other (specify below)

13 Insecticide storage

Direction from well?

How many feet?

FROM	TO	LITHOLOGIC LOG	FROM	TO	PLUGGING INTERVALS
0	.5'	ASPHALT W/ GRAVEL FILL BASE			
.5'	6'	SILTY CLAY, BROWN, STIFF, LOW PLASTICITY, MOIST, W/ FRACTURES, & BRICK FRAGMENTS & GRAVEL (FILL) GRADING VERY MOIST @ 3'			
6'	9'	SILTY SAND, BROWN, SORTED, FINE TO MED. GRAINED, ANGULAR TO SUBROUNDED, MOIST W/FE STAINING (ALLUVIUM)			
9'	12.5'	SAND, BROWN, FINE TO MED. GRAINED, POORLY SORTED, ANGULAR TO SUBROUNDED, MOIST (ALLUVIUM)			
12.5'	14'	GRADING VERY COARSE GRAINED			
14'	16'	GRADING WET			
16'	20'	GRADING W/ PEBBLE SIZED GRAVEL			

7 CONTRACTOR'S OR LANDOWNER'S CERTIFICATION: This water well was (1) constructed, (2) reconstructed, or (3) plugged under my jurisdiction and was completed on (mo/day/year) 3/28/94 and this record is true to the best of my knowledge and belief. KansasWater Well Contractor's License No. 549 This Water Well Record was completed on (mo/day/yr) 3/28/94under the business name of J & R DRILLING SERVICES, INC.by (signature) Raymond Cross